

License No. 7-1-10 Dated 10-1-10, 1910

Permit fee 125 OCT 65

STATE ENGINEER
Salem, Oregon

Well Record

STATE WELL NO. 27/15-25E(1)
COUNTY Lake
APPLICATION NO. U-765

OWNER: E. E. Lander

MAILING ADDRESS: 1675 Hall Lane

LOCATION OF WELL: Owner's No. _____

CITY AND STATE: Corvallis, Oregon


SW $\frac{1}{4}$ NW $\frac{1}{4}$ Sec. 25 T. 27 N. S., R. 15 E. W., W.M.

Bearing and distance from section or subdivision
corner S. 27° 31' 30" E. 2158 ft. from NW cor.
Sec. 25

Altitude at well _____

TYPE OF WELL: drilled Date Constructed Nov. 1955

Depth drilled 203 Depth cased 65'

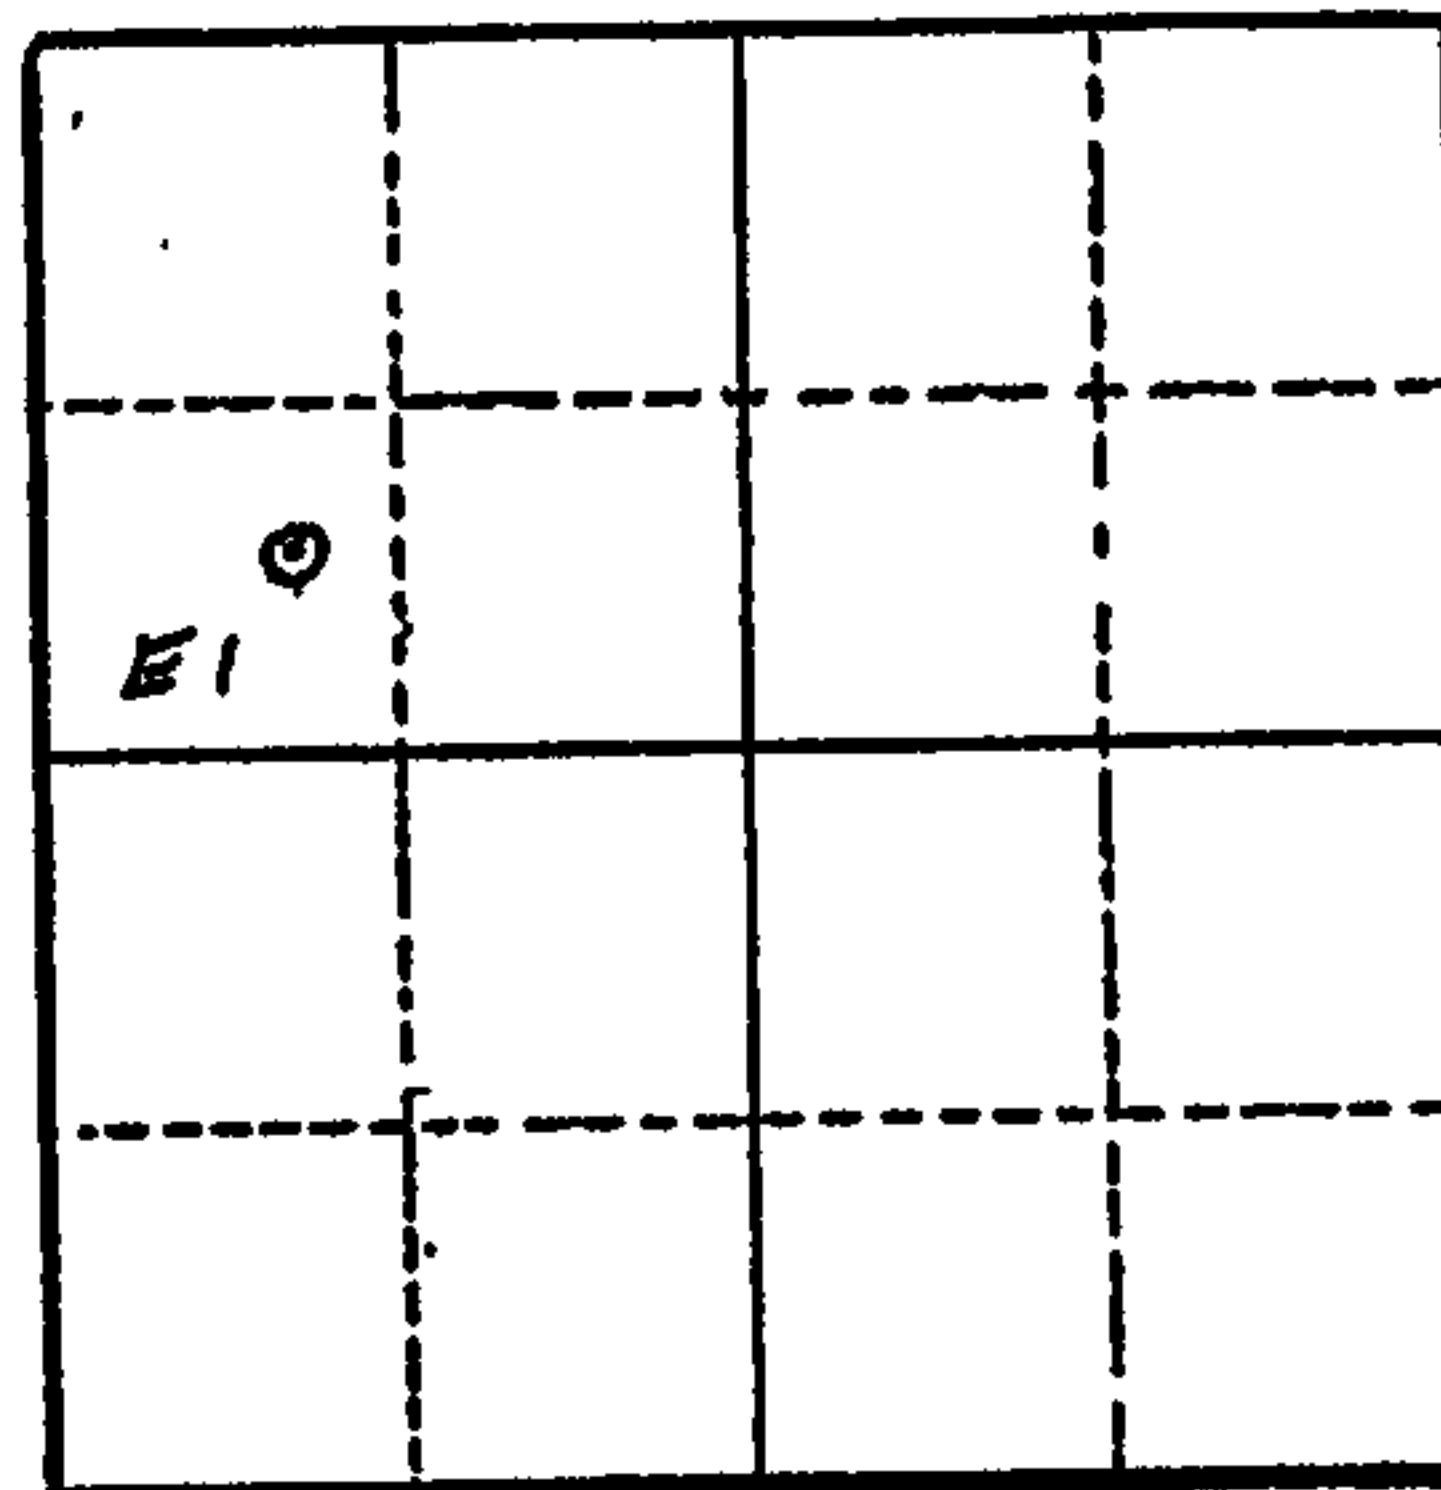

Section 25

CASING RECORD:

FINISH:

AQUIFERS:

WATER LEVEL:

PUMPING EQUIPMENT: Type _____ H.P. _____
Capacity _____ G.P.M.

WELL TESTS:

Drawdown _____ ft. after _____ hours _____ G.P.M.
Drawdown _____ ft. after _____ hours _____ G.P.M.

USE OF WATER Irrigation 128 acres Temp. _____ °F. _____, 19____

SOURCE OF INFORMATION _____

DRILLER or DIGGER _____

ADDITIONAL DATA:

Log _____ Water Level Measurements _____ Chemical Analysis _____ Aquifer Test _____

REMARKS: Permit U-706

Sid Mummerlyn tested well on 4/2/57

Pump set at 90 - no water was brought to surface

Pump set at 120 - 60 gpm