

LANE 10077.

STATE ENGINEER
Salem, Oregon

LANE Well Record

STATE WELL NO. 17/W - 28N
COUNTY LANE
APPLICATION NO. GR-2201

OWNER: George M. Easten


MAILING ADDRESS: Rt. 2 Box 382

LOCATION OF WELL: Owner's No.

CITY AND STATE: Springfield, Oregon

SW 1/4 SW 1/4 Sec. 28 T. 17 N. S. R. 1 W., W.M.

Bearing and distance from section or subdivision corner 660' E. and 690' N.

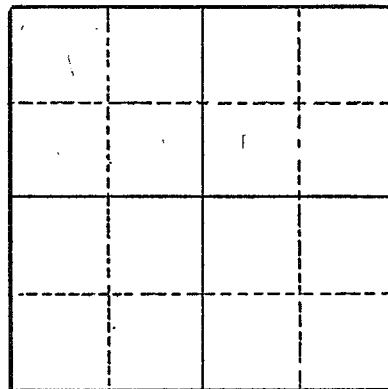

Section

Altitude at well

TYPE OF WELL: Dug Date Constructed 1945

Depth drilled 23 Depth cased 13 22

CASING RECORD:

12-Inch
36-Inch

FINISH:

AQUIFERS:

Gravel

WATER LEVEL:

12-Feet

PUMPING EQUIPMENT: Type Fairbanks Morse Centrifugal H.P. 10
Capacity 175 G.P.M.

WELL TESTS:

Drawdown 8 ft. after hours Pumping 100 G.P.M.
Drawdown ft. after hours G.P.M.

USE OF WATER Irrigation Temp. °F., 19

SOURCE OF INFORMATION GR-2106

DRILLER or DIGGER Owner

ADDITIONAL DATA:

Log X Water Level Measurements Chemical Analysis Aquifer Test

REMARKS:

River Bottom Loam 7
Gravel with little or no water 7
Gravel with water seams 4
Gravel and sand Tight formations 5



Oregon Water Resources Department
725 Summer Street NE, Suite A
Salem Oregon 97301
(503) 986-0900
www.oregon.gov/owrd

Application for Well ID Number

RECEIVED

JAN 17 2023

OWRD

Do not complete if the well already has a Well Identification Number.

I. OWNER INFORMATION

Current Owner Name (please print): Andrew L & Erin L Millspaugh
Mailing Address: 39003 Hendricks Park Rd
City, State, Zip: Springfield OR 97478
Mail Well ID to: ☒ SAME AS ABOVE ☐ In Care Of (C/O)
Name & Address: _____
City, State, Zip: _____

II. WELL LOCATION INFORMATION (Please fill out as completely as possible)

Township: 17 S (North / South) Range: 1 W (East / West) Section: 28 SW 1/4 of the SW 1/4
Tax Lot (usually last 3-5 numbers of Tax Map #): 1206 County Lane
GPS Coordinates: 44.057545, -122.822258 (per WR mapping tool)
Street Address of Well, City: 39003 Hendricks Park Rd
If the property had a different street address in the past: _____

III. GENERAL WELL INFORMATION (Please fill out as completely as possible, AND attach copy of Well Report, if available)

Use of Well (domestic, irrigation, commercial, industrial, monitoring): Irrigation
Date Well Constructed (or property built): 1945 Total Well Depth: 23" dug Casing Diameter: 12" & 36"
Owner at time the well was constructed (if known): George Easten Well Report # (if known): LANE 10077
Other Information: Irrigation Water Right Claim GR 2201

SUBMITTED BY (please print): Teresa Vitus (trustee of property)

PHONE: _____ EMAIL &/or FAX: _____

To send the completed application, you may MAIL it to: Oregon Water Resources Dept. 725 Summer St NE, Suite A, Salem, Oregon 97301.
Or EMAIL the completed PDF form to: Ladeena.K.Ashley@water.oregon.gov, or FAX it to: (503) 986-0902.

For Official Use Only by the Oregon Water Resources Department:

Received Date:

1-17-23

Well Report Number:

LANE 10077

Well Identification #:

L 150708