

STATE ENGINEER
Salem, Oregon

LANE Well Record
10124

STATE WELL NO. 17/1W-29F
COUNTY Lane
APPLICATION NO. GR-1587

GR- 1535

OWNER: Wayne Endicott


MAILING ADDRESS: Rt. 2, Box 9300

LOCATION OF WELL: Owner's No.

CITY AND STATE: Springfield, Oregon

SE 1/4 NW 1/4 Sec. 29 T. 17 S., R. 1 W., W.M.

Bearing and distance from section or subdivision
corner 1033' N. 58° W. from Center of Sec. 29

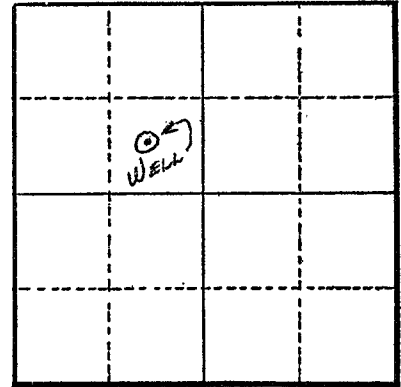

Section 29

Altitude at well 600'

TYPE OF WELL: Dug Date Constructed 1946

Depth drilled 16' Depth cased

CASING RECORD:

Dug - 48"

FINISH:

AQUIFERS:

WATER LEVEL:

14'

PUMPING EQUIPMENT: Type F. M. 2" Cent. H.P. 15

Capacity 300 G.P.M.

WELL TESTS:

Drawdown 3 ft. after 400 hours G.P.M.

Drawdown ft. after hours G.P.M.

USE OF WATER Irrigation Temp. °F., 19

SOURCE OF INFORMATION GR Record

DRILLER or DIGGER

ADDITIONAL DATA:

Log Water Level Measurements Chemical Analysis Aquifer Test

REMARKS:

Log: Newberg soil 0 to 5 ft.
Gravel (water) 5 to 16 ft.

Irrigation of 29.25 acres.