

STATE ENGINEER
Salem, Oregon

LANE **Well Record**
1025

STATE WELL NO. 17/1W-29F
COUNTY Lane
APPLICATION NO. GR-1588

GR- 1536

OWNER: Wayne Endicott


MAILING ADDRESS: Rt. 2, Box 9300

LOCATION OF WELL: Owner's No.

CITY AND STATE: Springfield, Oregon

SE 1/4 NW 1/4 Sec. 29 T. 17 S., R. 1 W., W.M.

Bearing and distance from section or subdivision corner 599' N.16°W. from Center Sec. 29.

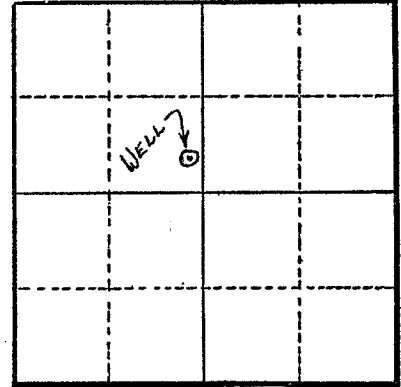

Section 29

Altitude at well 600'

TYPE OF WELL: Dug Date Constructed 1945

Depth drilled 16 1/2' Depth cased 16'

CASING RECORD:
12"

FINISH:

AQUIFERS:

WATER LEVEL:
14'

PUMPING EQUIPMENT: Type F. M. 2" Cent. H.P. 10
Capacity 300 G.P.M.

WELL TESTS:
Drawdown _____ ft. after _____ hours _____ G.P.M.
Drawdown _____ ft. after _____ hours _____ G.P.M.

USE OF WATER Irrigation Temp. _____ °F., 19

SOURCE OF INFORMATION GR Record

DRILLER or DIGGER

ADDITIONAL DATA:
Log _____ Water Level Measurements _____ Chemical Analysis _____ Aquifer Test _____

REMARKS:

Log: Newberg soil 0 to 5 ft.
Gravel (water) 5 to 16 1/2 ft.

Irrigation of 25.25 acres.