

STATE ENGINEER  
Salem, Oregon

OBSERVATION WELL  
Well Record

STATE WELL NO. 17/1W-29G(1)  
COUNTY Lane  
APPLICATION NO. GR-192

LAKE  
Lane 10/27

OWNER: Elwood MATTHEW  
Glen Vaughn


MAILING ADDRESS: Rt. 2, Box 378

LOCATION OF WELL: Owner's No. 2

CITY AND STATE: Springfield, Oregon

SW 1/4 NE 1/4 Sec. 29 T. 17 N. S. R. 1 E. W. W.M.

Bearing and distance from section or subdivision  
corner N. 72° 54' E. 408 ft. from SW cor. of  
NE 1/4 Sec. 29

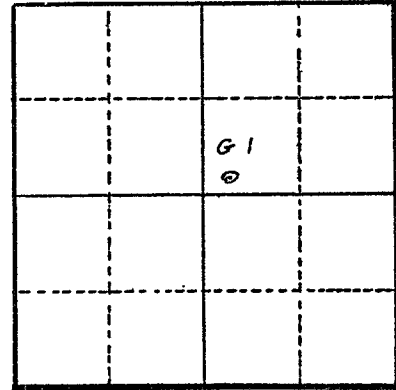

Altitude at well 450 ft. Interpolated

TYPE OF WELL: drilled Date Constructed 5/1/48

Depth drilled 43 ft. Depth cased 25 ft.

Section 29

CASING RECORD: 8 - inch casing set from 0 to 25 ft.

FINISH: no record

AQUIFERS: Sand & gravel from 8 to 25 ft.

WATER LEVEL: 25 ft. below land surface 5/5/48

PUMPING EQUIPMENT: Type Deming 2" centrifugal H.P. 7 1/2  
Capacity 180 G.P.M.

WELL TESTS:  
Drawdown 5 ft. after \_\_\_\_\_ hours pumping 120 G.P.M.  
Drawdown \_\_\_\_\_ ft. after \_\_\_\_\_ hours \_\_\_\_\_ G.P.M.

USE OF WATER Irrigation 27.29 acres Temp. \_\_\_\_\_ °F. 19

SOURCE OF INFORMATION Registration Statement GR-192

DRILLER or DIGGER

ADDITIONAL DATA:  
Log  Water Level Measurements \_\_\_\_\_ Chemical Analysis \_\_\_\_\_ Aquifer Test \_\_\_\_\_

REMARKS: Log: Loam 0 to 8 ft. 8 ft. thick  
Sand & gravel,  
water 8 to 25 ft. 17 ft. thick  
Gravel, cemented 25 to 41 ft. 16 ft. thick