

STATE ENGINEER
Salem, Oregon

LANE

10/29

Well Record

STATE WELL NO. 17/1W-29K(1)
COUNTY Lane
APPLICATION NO. GR-502

OWNER: Cecil E. Statzer

MAILING ADDRESS:

LOCATION OF WELL: Owner's No.


CITY AND STATE:

Springfield, Oregon

NW 1/4 SE 1/4 Sec. 29 T. 17 N. S. R. 1 E. W.M.

Bearing and distance from section or subdivision

corner N. 42° 59' W. 1750.8 ft. to NW cor. of SW 1/4 of Sec. 29

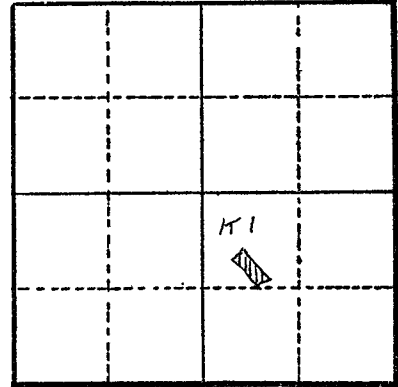

Section 29

Altitude at well 560

TYPE OF WELL: drilled Date Constructed Aug. 1950

Depth drilled 17 Depth cased 17

CASING RECORD: 2 inch

FINISH:

AQUIFERS:

WATER LEVEL: 8 ft.

PUMPING EQUIPMENT: Type _____ H.P. 1 1/2
Capacity 20 G.P.M.

WELL TESTS:
Drawdown _____ ft. after _____ hours _____ G.P.M.
Drawdown _____ ft. after _____ hours _____ G.P.M.

USE OF WATER irrigation 3.8 acres Temp. _____ °F. _____, 19

SOURCE OF INFORMATION GR-502

DRILLER or DIGGER Miller Jenson Co.; Eugene, Oregon

ADDITIONAL DATA:

Log No. Water Level Measurements _____ Chemical Analysis _____ Aquifer Test _____

REMARKS: