

STATE ENGINEER
Salem, Oregon

LANE Well Record
10/58

STATE WELL NO. 17/1W-30D
COUNTY LANE
APPLICATION NO. GR-3833

OWNER: Arlo Weeks

MAILING

ADDRESS: Rt 2 Box 392

CITY AND


STATE: Oregon

LOCATION OF WELL: Owner's No.

NW 1/4 NW 1/4 Sec. 30 T. 17 S., R. 1 W., W.M.

Bearing and distance from section or subdivision

corner 1027' E & 1075' S from NW cor Sec 30

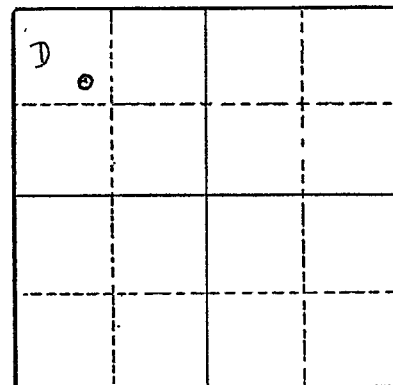

Altitude at well

TYPE OF WELL: Dug Date Constructed 1937

Depth drilled 12' Depth cased

Section 30

CASING RECORD:

FINISH:

AQUIFERS:

WATER LEVEL:

6'

PUMPING EQUIPMENT: Type Fairbanks Morse H.P. 5
Capacity 100 G.P.M.

WELL TESTS:

Drawdown 6" ft. after hours G.P.M.

Drawdown ft. after hours G.P.M.

USE OF WATER Irrigation Temp. °F. 19

SOURCE OF INFORMATION GR-3984

DRILLER or DIGGER

ADDITIONAL DATA:

Log NA Water Level Measurements Chemical Analysis Aquifer Test

REMARKS: