

STATE ENGINEER
Salem, Oregon

LANE
10/6/61

Well Record

STATE WELL NO. 17/1W-30M
COUNTY Lane
APPLICATION NO. GR-1384

GR- 1341

OWNER: Ethel K. or Robert W. Chase

MAILING
ADDRESS:

Rt. 2, Box 399


LOCATION OF WELL: Owner's No.

CITY AND
STATE:

Springfield, Oregon

NW 1/4 SW 1/4 Sec. 30 T. 17 S., R. 1 W., W.M.

Bearing and distance from section or subdivision
corner 293' E. & 15' S. from W 1/4 cor. Sec. 30.

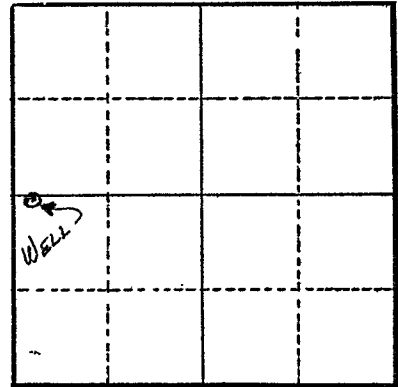

Section 30

Altitude at well 280 ft.

TYPE OF WELL: Dug Date Constructed 1946

Depth drilled 16 ft. Depth cased 16 ft.

CASING RECORD:

48 in. wood casing

FINISH:

AQUIFERS:

Sand & gravel

WATER LEVEL:

7 ft.

PUMPING EQUIPMENT: Type 2 in. Cent. H.P. 10

Capacity 250 G.P.M.

WELL TESTS:

Drawdown ft. after hours G.P.M.

Drawdown ft. after hours G.P.M.

USE OF WATER Irrigation Temp. °F., 19

SOURCE OF INFORMATION G. R. Record

DRILLER or DIGGER

ADDITIONAL DATA:

Log N.A. Water Level Measurements Chemical Analysis Aquifer Test

REMARKS:

Irrigation of 35 acres