

STATE ENGINEER
Salem, Oregon

Well Record **LANE** STATE WELL NO. 17/1W-31A
COUNTY Lane
10199 APPLICATION NO. GR-2410


OWNER: Harry L Marshall

MAILING ADDRESS: 9630 McKenzie Highway

LOCATION OF WELL: Owner's No. _____

CITY AND STATE: Oregon

NE 1/4 NE 1/4 Sec. 31 T. 17 N. S., R. 1 E. W., W.M.

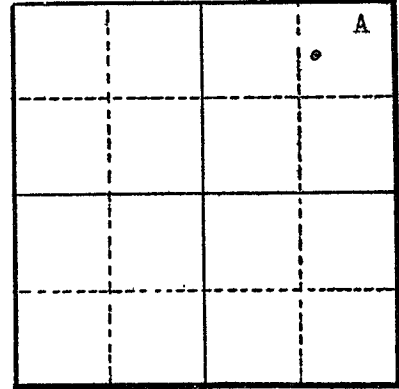

Bearing and distance from section or subdivision

corner 1310 feet West and 664 feet South of the NE
Corner of Section 31

Altitude at well 16 feet

TYPE OF WELL: Drilled Date Constructed 1942

Depth drilled 12 feet Depth cased 12 feet

Section 31

CASING RECORD:

6-inch steel casing set from 0 to 12 feet

FINISH:

AQUIFERS:

WATER LEVEL:

10 feet

PUMPING EQUIPMENT: Type Fairbanks Morse H.P. _____
Capacity 250 G.P.M.

WELL TESTS:

Drawdown _____ ft. after _____ hours _____ G.P.M.
Drawdown _____ ft. after _____ hours _____ G.P.M.

USE OF WATER Irrigation Temp. _____ °F. _____, 19____

SOURCE OF INFORMATION GR-4156

DRILLER or DIGGER _____

ADDITIONAL DATA:
Log (NA) Water Level Measurements _____ Chemical Analysis _____ Aquifer Test _____

REMARKS: