

STATE ENGINEER
Salem, Oregon

LANE Well Record

10200

STATE WELL NO. 17/1W-31B
COUNTY Lane
APPLICATION NO. GR-3186


OWNER: Guy Mathews

MAILING ADDRESS: 9582 McKenzie Highway

LOCATION OF WELL: Owner's No.

CITY AND STATE: Oregon

NW 1/4 NE 1/4 Sec. 31 T. 17 S., R. 1 E., W.M.

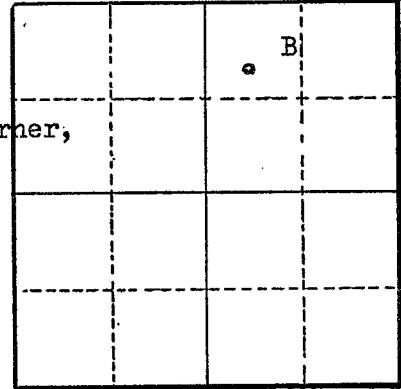

Bearing and distance from section or subdivision

corner 970 feet South and 685 feet East from the N1/4 Corner,

Section 31

Altitude at well

TYPE OF WELL: Dug Date Constructed 1950

Depth drilled 14 feet Depth cased 12 feet

Section 31

CASING RECORD:

33 inch-diameter 4-(3') tile set from 0 to 12 feet

FINISH:

AQUIFERS:

WATER LEVEL:

9 1/2 feet

PUMPING EQUIPMENT: Type G. E. Cent. 3 1/2"x3" H.P.
Capacity 400 G.P.M.

WELL TESTS:

Drawdown ft. after hours G.P.M.
Drawdown ft. after hours G.P.M.

USE OF WATER Irrigation Temp. °F., 19

SOURCE OF INFORMATION GR-4049

DRILLER or DIGGER Dug by Owner

ADDITIONAL DATA:

Log (NA) Water Level Measurements Chemical Analysis Aquifer Test

REMARKS: