

STATE ENGINEER
Salem, Oregon

Well Record

STATE WELL NO. 17/1-32E^W
COUNTY Lane
APPLICATION NO. GR-1491

LANE
10291

GR- 1441

OWNER: W. E. Watson


MAILING ADDRESS: Rt. 2, Box 115

LOCATION OF WELL: Owner's No. #1

CITY AND STATE: Springfield, Oregon

SW 1/4 NW 1/4 Sec. 32 T. 17 S., R. 1 W., W.M.

Bearing and distance from section or subdivision corner 1384' S. & 824' E. from NW cor. Sec. 32

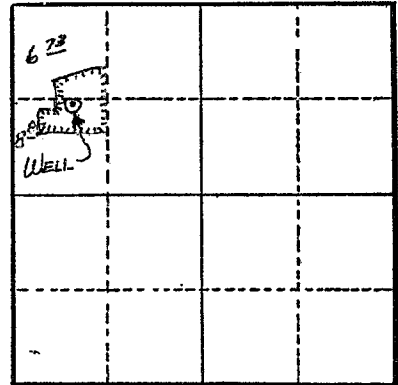

Section 32

Altitude at well 500'

TYPE OF WELL: Driven Date Constructed 1925

Depth drilled 15' Depth cased 15'

CASING RECORD:

4"

FINISH:

Perforated: 5 rows of 3/16" from 12' to 15'

AQUIFERS:

WATER LEVEL:

10'

PUMPING EQUIPMENT: Type F. M. 1 1/2" Cent. H.P. 7 1/2

Capacity 200 G.P.M.

WELL TESTS:

Drawdown ft. after hours G.P.M.

Drawdown ft. after hours G.P.M.

USE OF WATER Irrigation Temp. °F., 19

SOURCE OF INFORMATION GR Record

DRILLER or DIGGER

ADDITIONAL DATA:

Log N. A. Water Level Measurements Chemical Analysis Aquifer Test

REMARKS:

Irrigation of 15.53 acres.