

STATE ENGINEER  
Salem, Oregon

LANE Well Record  
10292

STATE WELL NO. 17/W-32F  
COUNTY Marion Lane  
APPLICATION NO. GR-3579

OWNER: Alva M. Colpitts


MAILING ADDRESS: Route 2, Box 148

LOCATION OF WELL: Owner's No.

CITY AND STATE: Springfield, Oregon

SE 1/4 NW 1/4 Sec. 32 T. 17 S. R. 1 W., W.M.

Bearing and distance from section or subdivision corner 1450 ft. E. and 1275 ft. N. from W1/4 corner

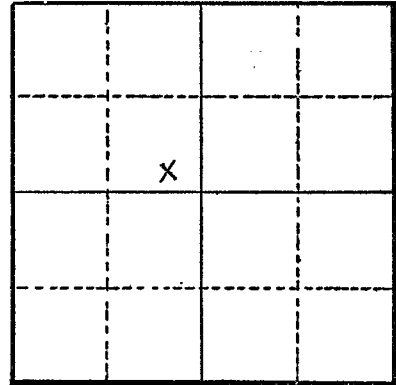

Section 32

Altitude at well

TYPE OF WELL: Driven Date Constructed June, 1949

Depth drilled 20 ft. Depth cased 20 ft.

CASING RECORD:

4 - 2 inch pipe casings set to 20 feet

FINISH:

Shot end from 17 ft. to 20 ft.

AQUIFERS:

WATER LEVEL:

10 feet below surface

PUMPING EQUIPMENT: Type G. E. centrifugal H.P. 10  
Capacity 200 G.P.M.

WELL TESTS:

Drawdown ft. after hours G.P.M.  
Drawdown ft. after hours G.P.M.

USE OF WATER Irrigation Temp. °F., 19

SOURCE OF INFORMATION Well Registration Statement

DRILLER or DIGGER Ed Odneal

ADDITIONAL DATA:

Log X Water Level Measurements Chemical Analysis Aquifer Test

REMARKS:

Log: Sand & gravel