

STATE ENGINEER
Salem, Oregon

LANE Well Record
10439

STATE WELL NO. 17/2W-3A
COUNTY Lane
APPLICATION NO. GR-3386

OWNER: C. D. Ruhlman


MAILING ADDRESS: 560 Park Ave.

LOCATION OF WELL: Owner's No. _____

CITY AND STATE: Eugene, Oregon

NE ¼ NE ¼ Sec. 3 T. 17 N. S., R. 2 E. W., W.M.

Bearing and distance from section or subdivision corner S. 53° 30' W. 1600'

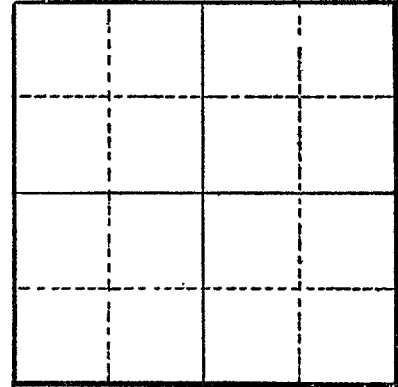

Section _____

Altitude at well _____

TYPE OF WELL: drive Date Constructed 1951

Depth drilled 21' Depth cased 21'

CASING RECORD:

2"

FINISH:

AQUIFERS:

WATER LEVEL:

16'

PUMPING EQUIPMENT: Type Fairbanks Morse H.P. 3
Capacity 150 G.P.M.

WELL TESTS:

Drawdown _____ ft. after _____ hours _____ G.P.M.

Drawdown _____ ft. after _____ hours _____ G.P.M.

USE OF WATER Irrigation Temp. _____ °F., 19 _____

SOURCE OF INFORMATION GR-3127

DRILLER or DIGGER _____

ADDITIONAL DATA:

Log _____ Water Level Measurements _____ Chemical Analysis _____ Aquifer Test _____

REMARKS: