

STATE ENGINEER
Salem, Oregon

Well Record

STATE WELL NO. 17/2W-22N
COUNTY Lane
APPLICATION NO. GR-937

OWNER: Leo Stump


MAILING ADDRESS:

LOCATION OF WELL: Owner's No.

CITY AND STATE: Springfield, Oregon

SW 1/4 SW 1/4 Sec. 22 T. 17 S., R. 2 W., W.M.

Bearing and distance from section or subdivision corner E. 1150 ft. & 375 ft. N. of SW cor. Sec. 22

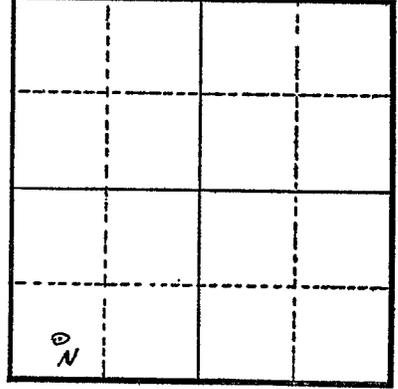

Section 22

Altitude at well 500

TYPE OF WELL: driven Date Constructed June 1955

Depth drilled 26 Depth cased 26

CASING RECORD: 4" driver 0 ft. to 26 ft.

FINISH: 10 per ft. slots 22 ft. - 26 ft.

AQUIFERS: Gravel 19 ft. - 26 ft.

WATER LEVEL: 7 ft. below land surface

PUMPING EQUIPMENT: Type Fairbanks Morse 2" centrifugal H.P. 7/2
Capacity 200 G.P.M.

WELL TESTS:
Drawdown ft. after hours G.P.M.
Drawdown ft. after hours G.P.M.

USE OF WATER irrigation Temp. °F. 19

SOURCE OF INFORMATION owner

DRILLER or DIGGER

ADDITIONAL DATA:
Log Water Level Measurements Chemical Analysis Aquifer Test

REMARKS:
Log: Loam 0 - 19 ft.
Gravel 19 - 26 ft.