

STATE ENGINEER
Salem, Oregon

Well Record

STATE WELL NO. 17/2W-22N
COUNTY LANE
APPLICATION NO. GR-2318

OWNER: S. U. Rencher


MAILING ADDRESS: Rt. 2, Box 474

LOCATION OF WELL: Owner's No.

CITY AND STATE: Springfield, Oregon

SW 1/4 SW 1/4 Sec. 22 T. 17 S., R. 2 W., W.M.

Bearing and distance from section or subdivision corner 780' N. and 300' E.

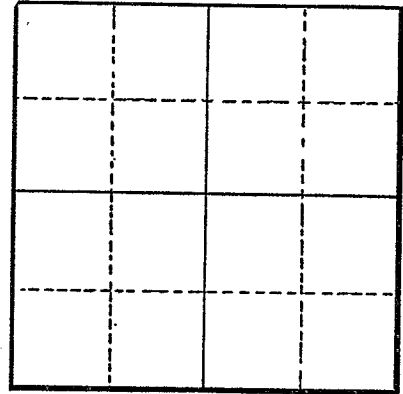

Section

Altitude at well

TYPE OF WELL: Driven Date Constructed 1945

Depth drilled 20 Depth cased

CASING RECORD:

FINISH:

1/4" Perforations
Perforated pipe Approx. 30" long.

AQUIFERS:

WATER LEVEL:

10-feet

PUMPING EQUIPMENT: Type Piston Type H.P. 1
Capacity 150 G.P.M.

WELL TESTS:

Drawdown not known ft. after hours Pumping 90 G.P.M.
Drawdown ft. after hours G.P.M.

USE OF WATER Irrigation Temp. °F., 19

SOURCE OF INFORMATION GR-2511

DRILLER or DIGGER Owner

ADDITIONAL DATA:

Log Water Level Measurements Chemical Analysis Aquifer Test

REMARKS: