

STATE ENGINEER
Salem, Oregon

Well Record

STATE WELL NO. 17/2W-25A(1)
COUNTY Lane
APPLICATION NO. GR-59

OWNER: assigned Virgil D. & Pauline Ward

MAILING ADDRESS: Rt. 2


LOCATION OF WELL: Owner's No. 1

CITY AND STATE: Springfield, Oregon

NE 1/4 NE 1/4 Sec. 25 T. 17 N. S. R. 2 W., W.M.

Bearing and distance from section or subdivision

corner 50 ft. S. of section line between Sec. 24
& 25

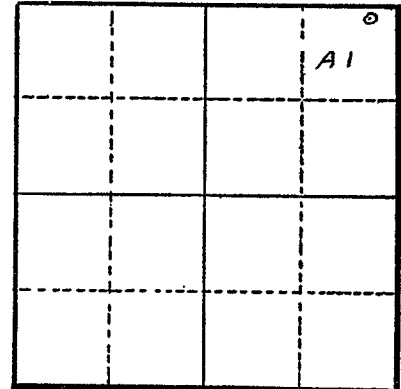

Altitude at well 450 ft. Interpolated

TYPE OF WELL: drilled Date Constructed April 1944

Depth drilled 20 Depth cased

Section 25

CASING RECORD:

FINISH:

AQUIFERS:

WATER LEVEL: 13 ft. below land surface April 1944

PUMPING EQUIPMENT: Type Fairbanks Morse H.P. 5
Capacity 250 G.P.M.

WELL TESTS:

Drawdown 4 ft. after 250 hours G.P.M.

Drawdown ft. after hours G.P.M.

USE OF WATER Irrigation 20 acres Temp. °F. 19

SOURCE OF INFORMATION Reg. Statement GR-59

DRILLER or DIGGER C. E. Gordinier & Sons

ADDITIONAL DATA:

Log No Water Level Measurements X Chemical Analysis Aquifer Test

REMARKS: