

STATE ENGINEER
Salem, Oregon


Well Record **LANE** STATE WELL NO. 17/2W-25H
10662 COUNTY Lane
GR- 1291 APPLICATION NO. GR- 1336

OWNER: Carl Terpening MAILING ADDRESS: Rt. 2, Box 397

LOCATION OF WELL: Owner's No. CITY AND STATE: Springfield, Oregon

SE 1/4 NE 1/4 Sec. 25 T. 17 S., R. 2 W., W.M.

Bearing and distance from section or subdivision
corner 2140' S. & 585' W. of NE cor. Sec. 25.

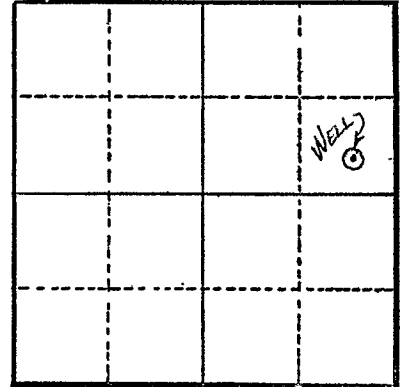

Section 25

Altitude at well 525 ft.

TYPE OF WELL: Dug Date Constructed 1942

Depth drilled 13 ft. Depth cased 13 ft.

CASING RECORD:
21 in.

FINISH:

AQUIFERS:

WATER LEVEL:

10 ft.

PUMPING EQUIPMENT: Type F. M. 2 in. Cent. H.P. 10
Capacity 270 G.P.M.

WELL TESTS:

Drawdown ft. after hours G.P.M.
Drawdown ft. after hours G.P.M.

USE OF WATER Irrigation Temp. °F., 19

SOURCE OF INFORMATION G. R. Record

DRILLER or DIGGER Owner

ADDITIONAL DATA:

Log Water Level Measurements Chemical Analysis Aquifer Test

REMARKS:

Log: Top soil 0 to 2 ft.
Coarse gravel 2 to 13 ft.
Stopped when reached sand.

Irrigation of 40 acres.