

STATE ENGINEER
Salem, Oregon

Well Record *LANE*

STATE WELL NO. 17/2W-260

COUNTY Lane

APPLICATION NO. GR-1369

GR- 1327

OWNER: James L. Gossler


MAILING ADDRESS: 1200 Weaver Lane

LOCATION OF WELL: Owner's No. #2

CITY AND STATE: Springfield, Oregon

SW 1/4 SE 1/4 Sec. 26 T. 7 N. S. R. 2 W., W.M.

Bearing and distance from section or subdivision corner 875' N. & 185' E. from S 1/4 cor. Sec. 26.

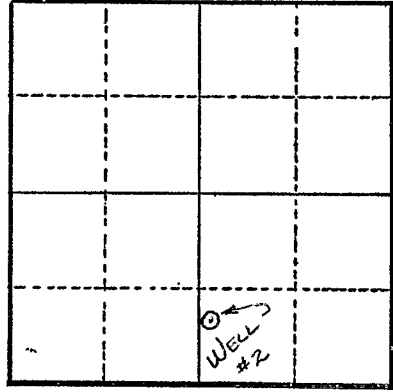

Section 26

Altitude at well 518 ft.

TYPE OF WELL: Driven Date Constructed 1952

Depth drilled 21 ft. Depth cased 21 ft.

CASING RECORD:

3 - 2 1/2 in. pipes connected

FINISH:

Blasted from 17 to 21 ft.

AQUIFERS:

WATER LEVEL:

10 ft.

PUMPING EQUIPMENT: Type Berkeley 4 x 5 in. Cent.

H.P. 20

Capacity 450 G.P.M.

WELL TESTS:

Drawdown ft. after hours G.P.M.

Drawdown ft. after hours G.P.M.

USE OF WATER Irrigation Temp. °F. 19

SOURCE OF INFORMATION G. R. Record

DRILLER or DIGGER

ADDITIONAL DATA:

Log N.A. Water Level Measurements Chemical Analysis Aquifer Test

REMARKS:

Irrigation of 28 acres.