

OWNER: Ben H. Pruitt


MAILING ADDRESS: 5790 Highbanks Rd.

LOCATION OF WELL: Owner's No.

CITY AND STATE: Springfield, Oregon

SE 1/4 SE 1/4 Sec. 28 T. 17 N. S., R. 2 E. W., W.M.

Bearing and distance from section or subdivision corner 360' N.

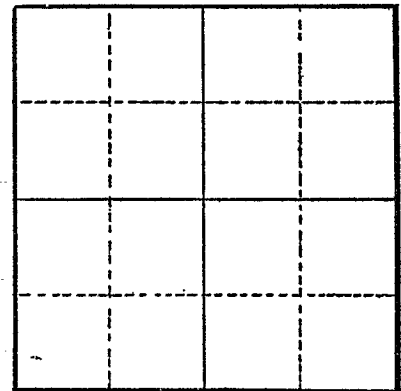

Section

Altitude at well

TYPE OF WELL: Drove Date Constructed 1947

Depth drilled 20 Depth cased 20

CASING RECORD:

- 3-inch
- 3-inch
- 3-inch

FINISH:

Shot end

AQUIFERS:

WATER LEVEL:

15-feet

PUMPING EQUIPMENT: Type Fairbanks Morse Centrifugal H.P. 20
Capacity 384 G.P.M.

WELL TESTS:

Drawdown ft. after hours G.P.M.
Drawdown ft. after hours G.P.M.

USE OF WATER Irrigation Temp. °F., 19

SOURCE OF INFORMATION GR-2765

DRILLER or DIGGER Ben H. Pruitt and L. D. Grosler 7776 Thurston Rd., Springfield, Ore.

ADDITIONAL DATA:

Log Water Level Measurements Chemical Analysis Aquifer Test

REMARKS: