

STATE ENGINEER
Salem, Oregon

WASH
LANE 10745

Well Record

STATE WELL NO. 17/2W-29C
COUNTY Lane
APPLICATION NO. GR-1799

GR-1740

OWNER: Malcolm W. Edmunson

MAILING

ADDRESS: Rt. 2, Box

LOCATION OF WELL: Owner's No. #1


CITY AND

STATE: Springfield, Oregon

NE 1/4 NW 1/4 Sec. 29 T. 17 S., R. 2 W., W.M.

Bearing and distance from section or subdivision

corner 580' S. & 250' W. from N¹/₄ cor. Sec. 29

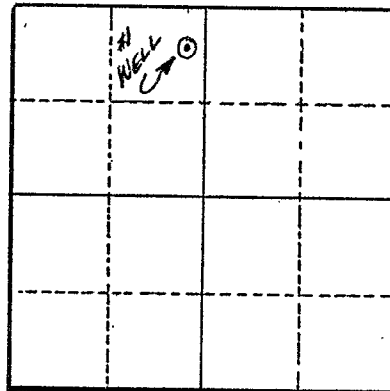

Section 29

Altitude at well 470'

TYPE OF WELL: Drilled Date Constructed 1948

Depth drilled 20' Depth cased 20'

CASING RECORD:

4"

FINISH:

Perforated

AQUIFERS:

WATER LEVEL:

10'

PUMPING EQUIPMENT: Type F. M. 2" Cent.

H.P. 7 1/2

Capacity 175 G.P.M.

WELL TESTS:

Drawdown Nil ft. after hours 200 G.P.M.

Drawdown ft. after hours G.P.M.

USE OF WATER Irrigation Temp. °F., 19

SOURCE OF INFORMATION GR Record

DRILLER or DIGGER

ADDITIONAL DATA:

Log Water Level Measurements Chemical Analysis Aquifer Test

REMARKS:

Log: Chehalis sandy loam 0 to 6 ft.
River gravel 6 to 20 ft.

Irrigation of 4.5 acres.