

STATE ENGINEER
Salem, Oregon

Well Record

STATE WELL NO. 17/2W-29G
APPLICATION NO. GR-1800

GR- 1741

OWNER: Paul B. Meyers


MAILING ADDRESS: Rt. 2

LOCATION OF WELL: Owner's No.

CITY AND STATE: Springfield, Oregon

NE $\frac{1}{4}$ NW $\frac{1}{4}$ Sec. 29 T. 17 S., R. 2 W., W.M.

Bearing and distance from section or subdivision corner 850' S. & 130' W. from NE¹ cor. Sec. 29

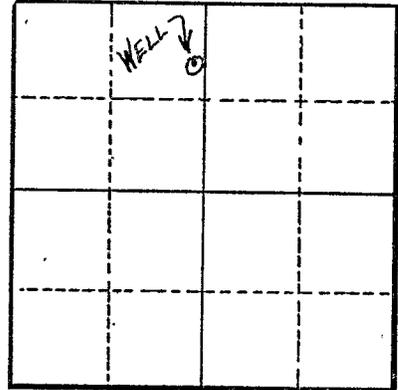

Section 29

Altitude at well 470'

TYPE OF WELL: Drilled Date Constructed 1928

Depth drilled 20' Depth cased 20'

CASING RECORD:

3"

FINISH:

Perforated

AQUIFERS:

WATER LEVEL:

10'

PUMPING EQUIPMENT: Type Deming 1 1/2" x 2" Cent. H.P. 5
Capacity 125 G.P.M.

WELL TESTS:

Drawdown Nil ft. after _____ hours 125 G.P.M.
Drawdown _____ ft. after _____ hours _____ G.P.M.

USE OF WATER Irrigation Temp. _____ °F., 19

SOURCE OF INFORMATION GR Record

DRILLER or DIGGER _____

ADDITIONAL DATA:

Log _____ Water Level Measurements _____ Chemical Analysis _____ Aquifer Test _____

REMARKS:

Log: Chehalis sandy clay loam 0 to 6 ft.
River gravel 6 to 20 ft.

Irrigation of 11 acres.