

STATE ENGINEER
Salem, Oregon

Well Record

STATE WELL NO. 17/2W-29F

COUNTY Lane

APPLICATION NO. GR-1803

GR-1744

107418

OWNER: Horace H. Myers


MAILING ADDRESS: Rt. 2

LOCATION OF WELL: Owner's No.

CITY AND STATE: Springfield, Oregon

SE 1/4 NW 1/4 Sec. 29 T. 17 S., R. 2 W., W.M.

Bearing and distance from section or subdivision corner 1910' S. & 880' W. from N¹/₄ cor. Sec. 29

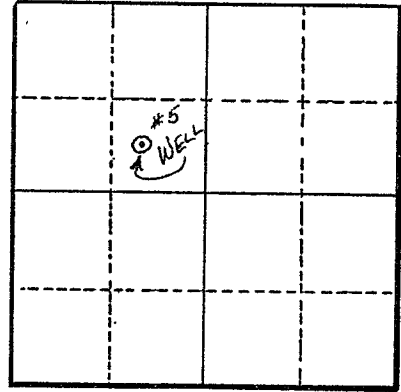

Section 29

Altitude at well 476'

TYPE OF WELL: Dug Date Constructed 1935

Depth drilled 14' Depth cased 14'

CASING RECORD:
28" concrete tile

FINISH:

AQUIFERS:

WATER LEVEL:

10'

PUMPING EQUIPMENT: Type F. M. 2 1/2" x 2" Cent. H.P. 10
Capacity 250 G.P.M.

WELL TESTS:

Drawdown Nil ft. after 300 hours G.P.M.
Drawdown ft. after hours G.P.M.

USE OF WATER Irrigation Temp. °F., 19

SOURCE OF INFORMATION GR record

DRILLER or DIGGER

ADDITIONAL DATA:

Log Water Level Measurements Chemical Analysis Aquifer Test

REMARKS:

Log: Newberg loam 0 to 4 ft.
River gravel 4 to 14 ft.

Irrigation of 22 acres.