

STATE ENGINEER
Salem, Oregon

Well Record **LANE** STATE WELL NO. 17/2W-29G
COUNTY Lane
APPLICATION NO. GR-1802

GR- 1743

OWNER: Phil F. Henry


MAILING ADDRESS: Rt. 2

LOCATION OF WELL: Owner's No. #4

CITY AND STATE: Springfield, Oregon

SW 1/4 NE 1/4 Sec. 29 T. 17 S., R. 2 W., W.M.

Bearing and distance from section or subdivision corner 1720' S. & 100' E. from NE 1/4 cor. Sec. 29

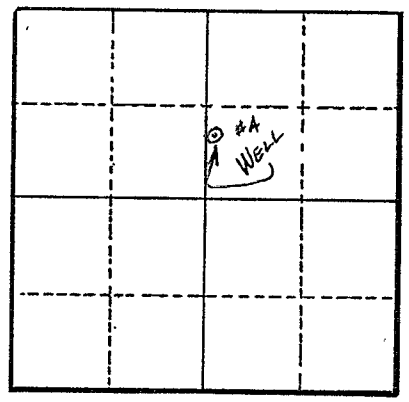

Section 29

Altitude at well 476'

TYPE OF WELL: Drilled Date Constructed 1926

Depth drilled 20' Depth cased 20'

CASING RECORD:

4"

FINISH:

Perforated

AQUIFERS:

WATER LEVEL:

12'

PUMPING EQUIPMENT: Type F. M. 1 1/2" x 2" Cent. H.P. 5
Capacity 125 G.P.M.

WELL TESTS:

Drawdown Nil ft. after 200 hours G.P.M.
Drawdown ft. after hours G.P.M.

USE OF WATER Irrigation Temp. °F. 19

SOURCE OF INFORMATION GR Record

DRILLER or DIGGER

ADDITIONAL DATA:

Log Water Level Measurements Chemical Analysis Aquifer Test

REMARKS:

Log: Chehalis sandy clay loam 0 to 6 ft.
River gravel 6 to 20 ft.

Irrigation of 8 acres.