

STATE ENGINEER
Salem, Oregon

Well Record

STATE WELL NO. 17/2W-29K
COUNTY Lane
APPLICATION NO. GR-1801

GR- 1742


110750

OWNER: Horace H. Myers
MAILING ADDRESS: Rt. 2

LOCATION OF WELL: Owner's No. CITY AND STATE: Springfield, Oregon

SW 1/4 NE 1/4 Sec. 29 T. 17 S., R. 2 W., W.M.

Bearing and distance from section or subdivision corner 1670' S. & 120' E. from N.E. cor. Sec. 29

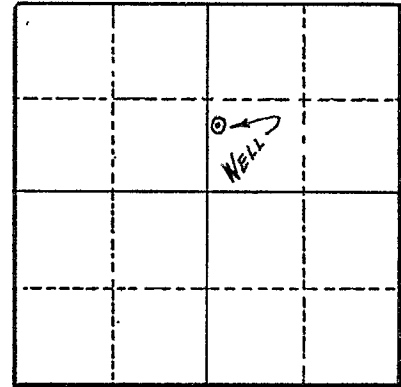

Altitude at well 476'

TYPE OF WELL: Drilled Date Constructed 1940

Depth drilled 20' Depth cased 20'

Section 29

CASING RECORD:

3"

FINISH:

Perforated

AQUIFERS:

WATER LEVEL:

12'

PUMPING EQUIPMENT: Type Deming 1 1/2" x 2" Cent. H.P. 5
Capacity 125 G.P.M.

WELL TESTS:

Drawdown Nil ft. after hours 150 G.P.M.

Drawdown ft. after hours G.P.M.

USE OF WATER Irrigation Temp. °F. 19

SOURCE OF INFORMATION GR Record

DRILLER or DIGGER

ADDITIONAL DATA:

Log Water Level Measurements Chemical Analysis Aquifer Test

REMARKS:

Log: Chehalis sandy clay loam 0 to 6 ft.
River gravel 6 to 20 ft.

Irrigation of 11 acres.