

STATE ENGINEER  
Salem, Oregon

# Well Record

*LANE* STATE WELL NO. 17/2W-36D  
COUNTY *Lane*  
APPLICATION NO. GR-1368

GR- 1326

OWNER: James L. Gossler


MAILING ADDRESS: 1200 Weaver Lane

LOCATION OF WELL: Owner's No. #1

CITY AND STATE: Springfield, Oregon

NW ¼ NW ¼ Sec. 36 T. 17 S., R. 2 W., W.M.

Bearing and distance from section or subdivision  
corner 720' S. & 165' E. from NW cor. Sec. 36

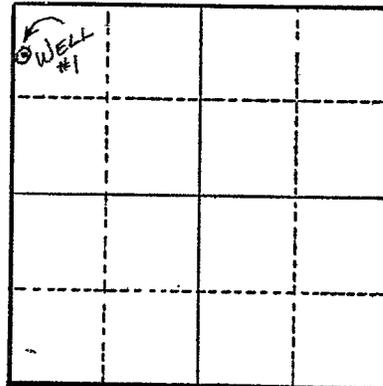

Section 36

Altitude at well 520 ft.

TYPE OF WELL: Driven Date Constructed 1942

Depth drilled 21 ft. Depth cased 21 ft.

### CASING RECORD:

3 - 2½ in. pipes connected

### FINISH:

Blasted from 17 to 21 ft.

### AQUIFERS:

### WATER LEVEL:

12 ft.

PUMPING EQUIPMENT: Type F. M. 2 in. Cent. H.P. 10  
Capacity 250 G.P.M.

### WELL TESTS:

Drawdown ..... ft. after ..... hours ..... G.P.M.  
Drawdown ..... ft. after ..... hours ..... G.P.M.

USE OF WATER Irrigation Temp. ..... °F. ...., 19

SOURCE OF INFORMATION G. R. Record

DRILLER or DIGGER .....

### ADDITIONAL DATA:

Log N.A. Water Level Measurements ..... Chemical Analysis ..... Aquifer Test .....

### REMARKS:

Irrigation of 20.6 acres.