

STATE ENGINEER  
Salem, Oregon

# Well Record

STATE WELL NO. 17/3-4F  
COUNTY LANE  
APPLICATION NO. GR-4203

10968

OWNER: Forrest G. Mickalson


MAILING ADDRESS: Rt. 2 Box 335

LOCATION OF WELL: Owner's No.

CITY AND STATE: Eugene, Oregon

SE 1/4 NW 1/4 Sec. 4 T. 17 S., R. 3 W., W.M.

Bearing and distance from section or subdivision  
corner NW property 31-62 chains S of NW cor.  
38 J. C. Spores Cl 38

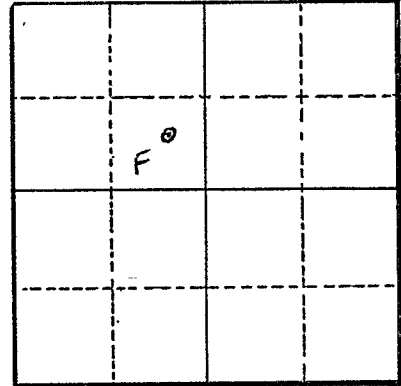

Section 4

Altitude at well

TYPE OF WELL: Driven Date Constructed NA

Depth drilled 28' Depth cased

### CASING RECORD:

### FINISH:

Perforated pipes no idea as to size or quantity of perforations

### AQUIFERS:

WATER LEVEL: 12'

PUMPING EQUIPMENT: Type Centrifical H.P.  
Capacity 450 G.P.M.

WELL TESTS:  
Drawdown ft. after hours over 450 G.P.M.  
Drawdown ft. after hours G.P.M.

USE OF WATER Irrigation Temp. °F., 19

SOURCE OF INFORMATION GR-3843

DRILLER or DIGGER NA

### ADDITIONAL DATA:

Log  Water Level Measurements Chemical Analysis Aquifer Test

REMARKS: 4' to gravel - water table  
at 12' - balance of strata  
gravel and water bearing