


STATE ENGINEER
Salem, Oregon

Well Record **LANE** STATE WELL NO. 17/3W-4F
COUNTY Lane
10969 APPLICATION NO. GR-4204

OWNER: Forrest G. Mickelson MAILING ADDRESS: Route 2, Box 335
CITY AND STATE: Eugene, Oregon

LOCATION OF WELL: Owner's No. _____
SE 1/4 NW 1/4 Sec. 4 T. 17 N. S., R. 3 E. W., W.M.
Bearing and distance from section or subdivision
corner NW property corner 31.62 chs. S. of NW
Cor. 38 J. C. Spore Cl. 38.

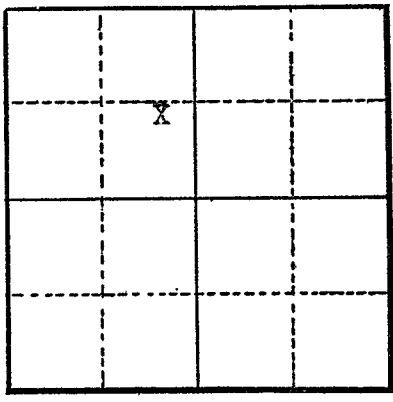

Section 4

Altitude at well _____
TYPE OF WELL: Driven Date Constructed 4/50
Depth drilled 21 ft. Depth cased _____

CASING RECORD:

FINISH:

AQUIFERS:

WATER LEVEL:
11 feet below surface

PUMPING EQUIPMENT: Type 2 1/2" centrifugal H.P. _____
Capacity _____ G.P.M.

WELL TESTS:
Drawdown _____ ft. after _____ hours _____ G.P.M.
Drawdown _____ ft. after _____ hours _____ G.P.M.

USE OF WATER Irrigation Temp. _____ °F. _____, 19
SOURCE OF INFORMATION Well Registration Statement Cert. # GR-3754

DRILLER or DIGGER F. G. Mickelson, owner
ADDITIONAL DATA:
Log Water Level Measurements _____ Chemical Analysis _____ Aquifer Test _____

REMARKS:
log:
4 ft. loam - balance gravel and sand - water bearing from 11 feet down.