

STATE ENGINEER
Salem, Oregon

Well Record

STATE WELL NO. 17/3W-4J(1)
COUNTY Lane
APPLICATION NO. GR-669


10970

OWNER: F. O. Crawford MAILING ADDRESS: Rt. 2, Box 332

LOCATION OF WELL: Owner's No. 1 CITY AND STATE: Eugene, Oregon

NE 1/4 SE 1/4 Sec. 4 T. 17 S., R. 3 W., W.M.

Bearing and distance from section or subdivision
corner N. 29° 28' W. 1642 ft. from SE cor. Sec. 4

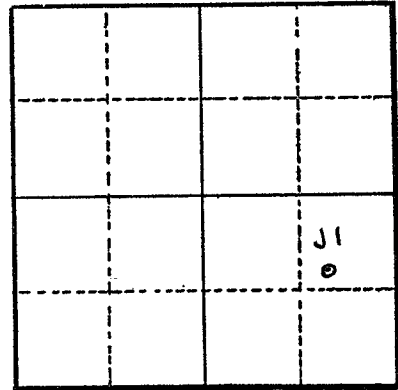

Section 4

Altitude at well 409 ft. Interpolated

TYPE OF WELL: Dug Date Constructed Summer 1950

Depth drilled 22 ft. Depth cased 22 ft.

CASING RECORD: 4 ft. square

FINISH:

AQUIFERS:

WATER LEVEL: 14 ft.

PUMPING EQUIPMENT: Type Berkeley centrifugal H.P. 10
Capacity 250 G.P.M.

WELL TESTS:
Drawdown 8 ft. after _____ hours 250 G.P.M.
Drawdown _____ ft. after _____ hours _____ G.P.M.

USE OF WATER irrigation 29 acres Temp. _____ °F. _____, 19____

SOURCE OF INFORMATION GR-669

DRILLER or DIGGER _____

ADDITIONAL DATA:

Log Water Level Measurements _____ Chemical Analysis _____ Aquifer Test _____

REMARKS: Log: Soil 0 to 10 ft.
Cemented gravel 10 to 22 ft.