

STATE ENGINEER  
Salem, Oregon

# Well Record


STATE WELL NO. 17/3W-4K(1)  
Lane  
COUNTY \_\_\_\_\_  
APPLICATION NO. GR-315

12971

OWNER: Neils O. Egge  
MAILING ADDRESS: Rt. 2, Box 326  
CITY AND STATE: Eugene, Oregon

LOCATION OF WELL: Owner's No. 1  
NW  $\frac{1}{4}$  SE  $\frac{1}{4}$  Sec. 4 T. 17 S., R. 3 W., W.M.

Bearing and distance from section or subdivision  
corner N. 54° 16' W. 3169.1 ft. from SE cor. Sec. 4

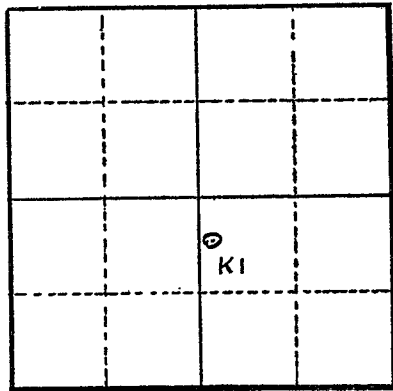

Altitude at well 400 ft. Interpolated

TYPE OF WELL: dug&drilled Date Constructed May 1946  
Depth drilled 32 ft. Depth cased 32 ft.

Section 4

CASING RECORD: 4 ft. diameter steam boiler set from 0 to 14 ft.  
12 - in. pipe set from 14 to 32 ft.

FINISH: 3 -  $\frac{1}{4}$ " x 8" slots per foot from 14 to 32 ft.

AQUIFERS: Sand & gravels & boulders 6 to 32 ft.

WATER LEVEL: 14 ft. below land surface June 1956

PUMPING EQUIPMENT: Type Peerless pump centrifugal H.P. 20  
Capacity 650 G.P.M.

WELL TESTS:  
Drawdown \_\_\_\_\_ ft. after \_\_\_\_\_ hours \_\_\_\_\_ G.P.M.  
Drawdown \_\_\_\_\_ ft. after \_\_\_\_\_ hours \_\_\_\_\_ G.P.M.

USE OF WATER Irrigation 47 acres Temp. \_\_\_\_\_ °F. \_\_\_\_\_, 19\_\_\_\_  
SOURCE OF INFORMATION \_\_\_\_\_ Reg. State. GR-315

DRILLER or DIGGER \_\_\_\_\_  
ADDITIONAL DATA:  
Log X Water Level Measurements \_\_\_\_\_ Chemical Analysis \_\_\_\_\_ Aquifer Test \_\_\_\_\_

REMARKS: Log: Loam 0 - 6 ft. 6 ft.  
Sand & gravel 6 - 14 ft. 8 ft.  
Large gravels 14 - 32 ft. 18 ft.

\* water bearing from 12 to 32 ft.