

STATE ENGINEER
Salem, Oregon

Well Record

STATE WELL NO. 17/3W-5A
COUNTY Lane
APPLICATION NO. GR-3228

10982

OWNER: Leon H. and/or Flossie Funke


MAILING ADDRESS: Route 2, Box 366

LOCATION OF WELL: Owner's No. 1 (Able place)

CITY AND STATE: Eugene, Oregon

NE 1/4 NE 1/4 Sec. 5 T. 17 S., R. 3 W., W.M.

Bearing and distance from section or subdivision corner S. 400'; W. 750' from the N.E. corner of Section 5

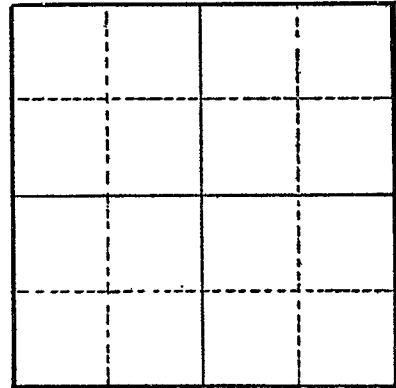

Section

Altitude at well

TYPE OF WELL: driven Date Constructed 1951

Depth drilled 27 Depth cased

CASING RECORD:

FINISH:

Slotted 1/8" x 6"; 6 per foot, from 23 1/2 to 27

AQUIFERS:

WATER LEVEL:

12 feet

PUMPING EQUIPMENT: Type Fairbanks Morse, Cent. H.P. 10
Capacity 260 G.P.M.

WELL TESTS:

Drawdown ft. after hours G.P.M.
Drawdown ft. after hours G.P.M.

USE OF WATER Irrigation Temp. °F., 19.....

SOURCE OF INFORMATION GR-3005

DRILLER or DIGGER

ADDITIONAL DATA:

Log Water Level Measurements Chemical Analysis Aquifer Test

REMARKS: