

STATE ENGINEER
Salem, Oregon

Well Record

STATE WELL NO. 17/3W-5B
COUNTY Lane
APPLICATION NO. GR-3222

10983

OWNER: Leon E. and/or Flossie Funke


MAILING ADDRESS: Route 2, Box 366

LOCATION OF WELL: Owner's No. _____

CITY AND STATE: Eugene, Oregon

NW 1/4 NE 1/4 Sec. 5 T. 17 N. 3 W., W.M.

Bearing and distance from section or subdivision corner S. 650'; W. 2100' from the N.E. corner of Section 5

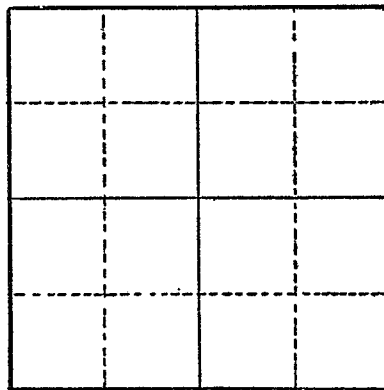

Section _____

Altitude at well _____

TYPE OF WELL: driven Date Constructed 1940

Depth drilled 21 Depth cased _____

CASING RECORD: _____

FINISH:

Slots 1/8" by 6" about 6 per foot from 17 to 21

AQUIFERS: _____

WATER LEVEL:

12 feet

PUMPING EQUIPMENT: Type Allis Chalmers, Centrifugal H.P. 15
Capacity 400 G.P.M.

WELL TESTS:

Drawdown _____ ft. after _____ hours _____ G.P.M.

Drawdown _____ ft. after _____ hours _____ G.P.M.

USE OF WATER Irrigation Temp. _____ °F., 19 _____

SOURCE OF INFORMATION GR2999

DRILLER or DIGGER Harry Harbert, Route 2, Eugene, Oregon

ADDITIONAL DATA:

Log _____ Water Level Measurements _____ Chemical Analysis _____ Aquifer Test _____

REMARKS: _____