

STATE ENGINEER
Salem, Oregon

Well Record

STATE WELL NO. 17/3W-5A
COUNTY Lane
APPLICATION NO. GR-3229

10984

OWNER: Leon H. and/or Flossie Funke


MAILING ADDRESS: route 2, Box 366

LOCATION OF WELL: Able Place
Owner's No. #2

CITY AND STATE: Eugene, Oregon

NE 1/4 NE 1/4 Sec. 5 T. 17 S., R. 3 W., W.M.

Bearing and distance from section or subdivision
corner S. 270' W. 600' from the NE corner
of Section 5.

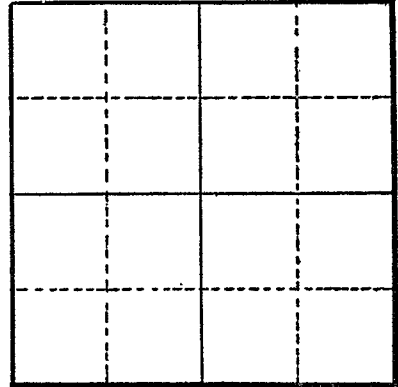

Section

Altitude at well

TYPE OF WELL: driven Date Constructed 1940

Depth drilled 18 Depth cased

CASING RECORD:

FINISH:

slotted 1/8" x 6" about 5 perfoot from 15 to 18

AQUIFERS:

WATER LEVEL:

8'

PUMPING EQUIPMENT: Type Bingham centrifugal H.P.
Capacity 260 G.P.M.

WELL TESTS:

Drawdown ft. after hours G.P.M.
Drawdown ft. after hours G.P.M.

USE OF WATER Irrigation Temp. °F., 19

SOURCE OF INFORMATION GR-3006

DRILLER or DIGGER

ADDITIONAL DATA:

Log Water Level Measurements Chemical Analysis Aquifer Test

REMARKS: