

STATE ENGINEER
Salem, Oregon

Well Record

STATE WELL NO. 17/3W-5B
COUNTY Lane
APPLICATION NO. ER-3221

10985

OWNER: Mrs. Minnie J. Funke


MAILING ADDRESS: Route 2, Box 375

LOCATION OF WELL: Owner's No. 2

CITY AND STATE: Eugene, Oregon

NW $\frac{1}{4}$ NE $\frac{1}{4}$ Sec. 5 T. 17 S., R. 3 W., W.M.

Bearing and distance from section or subdivision corner S. 1260', W. 1950' from the N.E. corner of Section 5

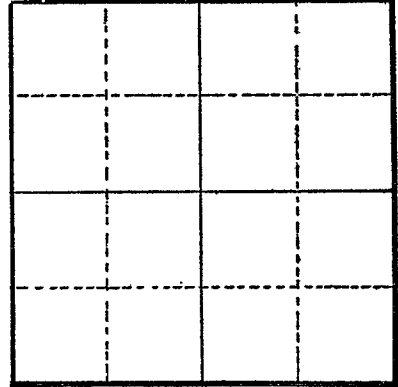

Section

Altitude at well

TYPE OF WELL: driven Date Constructed 1937

Depth drilled 21 Depth cased

CASING RECORD:

FINISH:

Drilled $\frac{1}{4}$ " holes 16 per foot from 17.5 to 21

AQUIFERS:

WATER LEVEL:
10 feet

PUMPING EQUIPMENT: Type Fairbanks Morse Centrifugal H.P. 26
Capacity 360 G.P.M.

WELL TESTS:
Drawdown ft. after hours G.P.M.
Drawdown ft. after hours G.P.M.

USE OF WATER Irrigation Temp. °F., 19

SOURCE OF INFORMATION CR-2998

DRILLER or DIGGER

ADDITIONAL DATA:

Log Water Level Measurements Chemical Analysis Aquifer Test

REMARKS: