


STATE ENGINEER
Salem, Oregon

Well Record ^{ANE} STATE WELL NO. 17/3W-5B
10988 COUNTY Lane
APPLICATION NO. GR-3220

OWNER: Mrs. Minnie J. Funke
MAILING ADDRESS: Route 2, Box 375
CITY AND STATE: Eugene, Oregon

LOCATION OF WELL: Owner's No. 1
NW 1/4 NE 1/4 Sec. 5 T. 17 S., R. 3 W., W.M.

Bearing and distance from section or subdivision corner
S. 1385' W. 1551' from the N.E. corner of Section 5

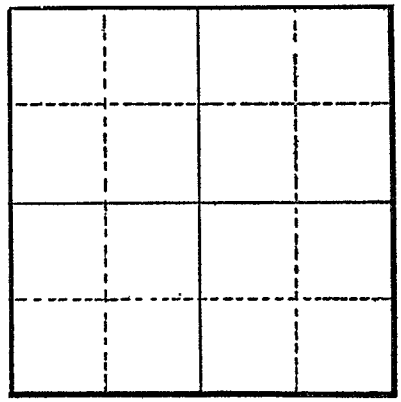

Section

Altitude at well

TYPE OF WELL: driven Date Constructed 1951
Depth drilled 21 Depth cased

CASING RECORD:

FINISH:

Slotted 1/4" x 6" 6 per ft from 17.5 to 21

AQUIFERS:

WATER LEVEL:

10 feet

PUMPING EQUIPMENT: Type Allis Chalmers, centrifugal H.P. 15
Capacity 360 G.P.M.

WELL TESTS:

Drawdown ft. after hours G.P.M.
Drawdown ft. after hours G.P.M.

USE OF WATER Irrigation Temp. °F., 19

SOURCE OF INFORMATION GR-2997

DRILLER or DIGGER

ADDITIONAL DATA:

Log Water Level Measurements Chemical Analysis Aquifer Test

REMARKS: