


STATE ENGINEER
Salem, Oregon

Well Record **LANE** STATE WELL NO. 17/3W - 6A
1099.5 COUNTY **LANE**
APPLICATION NO. GR-2198

OWNER: Victor Lanini
MAILING ADDRESS: Box 45
CITY AND STATE: Coburg, Oregon

LOCATION OF WELL: Owner's No. _____
NE 1/4 NE 1/4 Sec. 6 T. 17 S., R. 3 E., W.M.
Bearing and distance from section or subdivision
corner 2474' 11" S. and 746' 6" W.

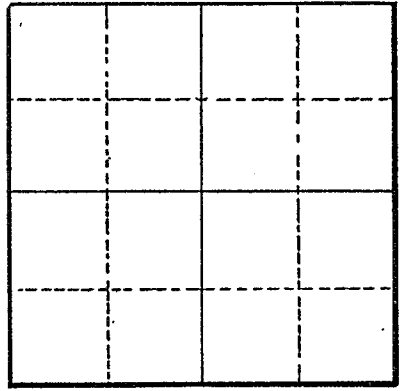

Section _____

Altitude at well _____
TYPE OF WELL: Driven Date Constructed 1945
Depth drilled 15 Depth cased 15

CASING RECORD:

4-Inch

FINISH:

AQUIFERS:

WATER LEVEL: 10-Feet

PUMPING EQUIPMENT: Type Allis Chalmers H.P. 20
Capacity 400 G.P.M.

WELL TESTS:
Drawdown _____ ft. after _____ hours _____ G.P.M.
Drawdown _____ ft. after _____ hours _____ G.P.M.

USE OF WATER Irrigation Temp. _____ °F. _____, 19
SOURCE OF INFORMATION GR-2103

DRILLER or DIGGER _____
ADDITIONAL DATA:
Log _____ Water Level Measurements _____ Chemical Analysis _____ Aquifer Test _____

REMARKS: