

STATE ENGINEER
Salem, Oregon

Well Record **LANE** STATE WELL NO. 17/3W-6A
10996 COUNTY Lane
APPLICATION NO. GR-857

OWNER: Victor Lanini & Marie M. Lanini


MAILING ADDRESS: Box 45

LOCATION OF WELL: Owner's No.

CITY AND STATE: Coburg, Oregon

NE 1/4 NE 1/4 Sec. 6 T. 17^N S., R. 3^E W., W.M.

Bearing and distance from section or subdivision
corner 2474' 11" S. & 746' 6" W. of NW cor.
John C. Mansfield DLC 59 in Sec. 32

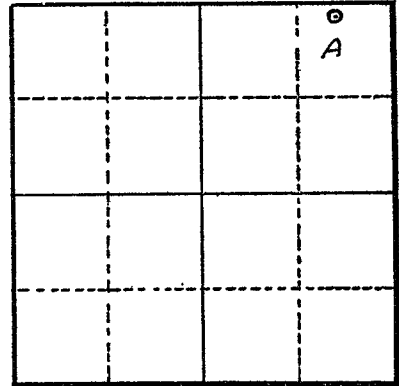

Section 6

Altitude at well 320 ft.

TYPE OF WELL: driven Date Constructed Aug. 1945

Depth drilled 15 Depth cased 15

CASING RECORD: 2 - 10' apart
4" steel 0 to 15 ft.

FINISH:

AQUIFERS:

WATER LEVEL: 10 ft.

PUMPING EQUIPMENT: Type Allis Chalmers high pressure H.P.
Capacity 400 G.P.M.

WELL TESTS:
Drawdown _____ ft. after _____ hours _____ G.P.M.
Drawdown _____ ft. after _____ hours _____ G.P.M.

USE OF WATER irrigation Temp. _____ °F., 19

SOURCE OF INFORMATION owner

DRILLER or DIGGER

ADDITIONAL DATA:

Log No Water Level Measurements Chemical Analysis Aquifer Test

REMARKS: