

STATE ENGINEER  
Salem, Oregon

Well Record **LANE** STATE WELL NO. 17/3W-9H  
COUNTY Lane  
**11065** APPLICATION NO. GR-3385

OWNER: Paul E. Rhoads


MAILING ADDRESS: Route 2, Box 295

LOCATION OF WELL: Owner's No. \_\_\_\_\_

CITY AND STATE: Eugene, Oregon

SE  $\frac{1}{4}$  NE  $\frac{1}{4}$  Sec. 9 T. 17 <sup>N.</sup> S., R. 3 <sup>E.</sup> W., W.M.

Bearing and distance from section or subdivision  
corner 2100' S. and 400' W.

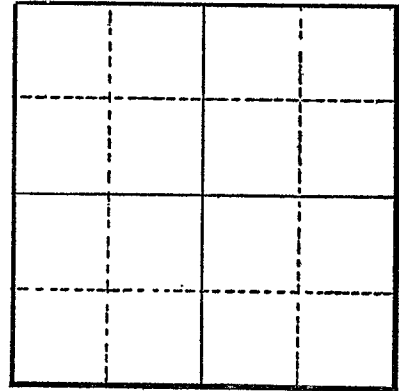

Section \_\_\_\_\_

Altitude at well \_\_\_\_\_

TYPE OF WELL: drive Date Constructed 1949

Depth drilled 20' Depth cased 20'

CASING RECORD:

4"

FINISH:

one blown and one slotted from 17 to 20

AQUIFERS:

WATER LEVEL:

7'

PUMPING EQUIPMENT: Type Demming Mueller H.P. 10  
Capacity 350 G.P.M.

WELL TESTS:

Drawdown \_\_\_\_\_ ft. after \_\_\_\_\_ hours \_\_\_\_\_ G.P.M.

Drawdown \_\_\_\_\_ ft. after \_\_\_\_\_ hours \_\_\_\_\_ G.P.M.

USE OF WATER Irrigation Temp. \_\_\_\_\_ °F., 19 \_\_\_\_\_

SOURCE OF INFORMATION GR-3126

DRILLER or DIGGER Casey Jones Pleasant Hill, Oregon

ADDITIONAL DATA:

Log \_\_\_\_\_ Water Level Measurements \_\_\_\_\_ Chemical Analysis \_\_\_\_\_ Aquifer Test \_\_\_\_\_

REMARKS: