

STATE ENGINEER
Salem, Oregon

Well Record

STATE WELL NO. 17/3W-9N
COUNTY Lane
APPLICATION NO. GR-1839

GR-1784

ANE
11066

OWNER: Archie E. John

MAILING

ADDRESS: 3227 Coburg Rd.

LOCATION OF WELL: Owner's No.


CITY AND

STATE: Eugene, Oregon

SW 1/4 SW 1/4 Sec. 9 T. 17 S., R. 3 W., W.M.

Bearing and distance from section or subdivision

corner 260' N. & 1585' W. from S 1/4 cor. Sec. 9

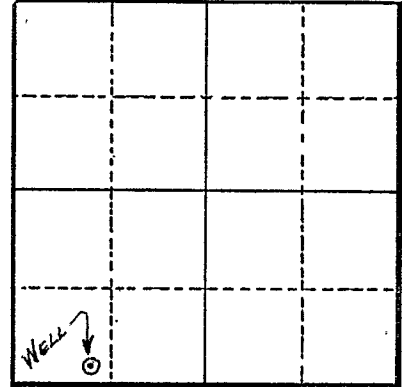

Section 9

Altitude at well 400'

TYPE OF WELL: Drilled Date Constructed 1955

Depth drilled 37' Depth cased 37'

CASING RECORD:

4"

FINISH:

AQUIFERS:

WATER LEVEL:

9'

PUMPING EQUIPMENT: Type Sears 1 1/4" x 1" & Sta-Rite 1 1/2" x 1" H.P. Both 1
Capacity 100 G.P.M.

WELL TESTS:

Drawdown 18 ft. after hours 100 G.P.M.

Drawdown ft. after hours G.P.M.

USE OF WATER Irrigation Temp. °F. 19

SOURCE OF INFORMATION GR Record

DRILLER or DIGGER Curt Miller

ADDITIONAL DATA:

Log Water Level Measurements Chemical Analysis Aquifer Test

REMARKS:

Log: Top soil 0 to 3 ft.
Gravel & sand 3 to 37 ft.

Irrigation of 4.64 acres.