

STATE ENGINEER  
Salem, Oregon


# Well Record

STATE WELL NO. 17/3W-9R  
COUNTY Lane  
APPLICATION NO. GR-3556

11067

OWNER: Hoiland Bros.  
MAILING ADDRESS: Route 2, Box 299-B  
CITY AND STATE: Eugene, Oregon

LOCATION OF WELL: Owner's No. \_\_\_\_\_  
SE 1/4 SE 1/4 Sec. 9 T. 17 S., R. 3 W., W.M.  
Bearing and distance from section or subdivision  
corner 775' N. and 765' W. of the SE corner  
of Sec. 9

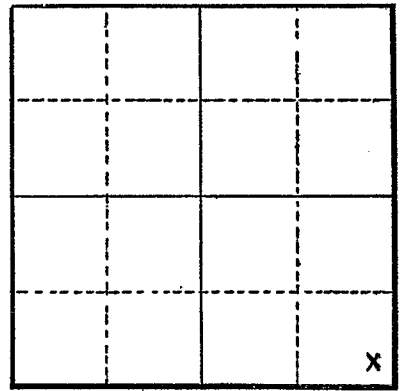

Section 9

Altitude at well \_\_\_\_\_

TYPE OF WELL: Driven Date Constructed 3/25/49

Depth drilled 20 ft. Depth cased \_\_\_\_\_

CASING RECORD:

FINISH:

AQUIFERS:

WATER LEVEL:

5 feet below surface

PUMPING EQUIPMENT: Type Pacific Centrifugal 3" H.P. 10  
Capacity 252 G.P.M.

WELL TESTS:

Drawdown \_\_\_\_\_ ft. after \_\_\_\_\_ hours \_\_\_\_\_ G.P.M.  
Drawdown \_\_\_\_\_ ft. after \_\_\_\_\_ hours \_\_\_\_\_ G.P.M.

USE OF WATER Irrigation Temp. \_\_\_\_\_ °F., 19

SOURCE OF INFORMATION Well Registration Statement

DRILLER or DIGGER Hoiland Bros.

ADDITIONAL DATA:

Log \_\_\_\_\_ Water Level Measurements \_\_\_\_\_ Chemical Analysis \_\_\_\_\_ Aquifer Test \_\_\_\_\_

REMARKS: