

STATE ENGINEER  
Salem, Oregon


# Well Record

STATE WELL NO. 17/3W-10L  
COUNTY Lane  
APPLICATION NO. GR-3905

11088

OWNER: Earl J. Perry  
MAILING ADDRESS: Route 2, Box 288  
CITY AND STATE: Eugene, Oregon

LOCATION OF WELL: Owner's No. \_\_\_\_\_  
NE 1/4 SW 1/4 Sec. 10 T. 17 S., R. 3 W., W.M.  
Bearing and distance from section or subdivision  
corner 1430' N. and 1422' E. of SW Cor.

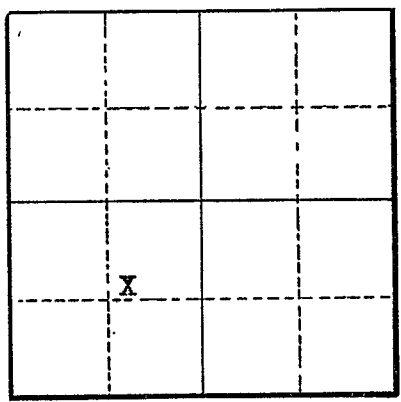

Section 10

Altitude at well \_\_\_\_\_  
TYPE OF WELL: Driven Date Constructed 1945  
Depth drilled 20 ft. Depth cased 20 ft.

### CASING RECORD:

2 inch standard galvanized pipe from surface to 20 feet

### FINISH:

7 ft. 6 in. apart, 20 ft. deep, coupled at top and pump draws from center of coupling.

### AQUIFERS:

### WATER LEVEL:

11 feet below surface

PUMPING EQUIPMENT: Type Fairbanks Morse H.P. 5  
Capacity 120 G.P.M.

### WELL TESTS:

Drawdown \_\_\_\_\_ ft. after \_\_\_\_\_ hours \_\_\_\_\_ G.P.M.  
Drawdown \_\_\_\_\_ ft. after \_\_\_\_\_ hours \_\_\_\_\_ G.P.M.

USE OF WATER Irrigation Temp. \_\_\_\_\_ °F., 19

SOURCE OF INFORMATION Well Registration Statement Cert. # GR-3546

DRILLER or DIGGER \_\_\_\_\_

### ADDITIONAL DATA:

Log  Water Level Measurements \_\_\_\_\_ Chemical Analysis \_\_\_\_\_ Aquifer Test \_\_\_\_\_

### REMARKS:

Log: Approximately 3 ft. of soil, then gravel on down. Water level varies with rise and fall of McKenzie River. From 10 to 15 feet during summer months.