

STATE ENGINEER  
Salem, Oregon

# Well Record

STATE WELL NO. 17/3W-10L  
COUNTY LANE  
APPLICATION NO. GR-2829

OWNER: John Langan


MAILING ADDRESS: Rt. 2 Box 288, Eugene, Oregon

LOCATION OF WELL: Owner's No.

CITY AND STATE:

NE 1/4 SW 1/4 Sec. 10 T. 17 N. S, R. 3 E. W., W.M.

Bearing and distance from section or subdivision corner 1850' N. and 1728' E.

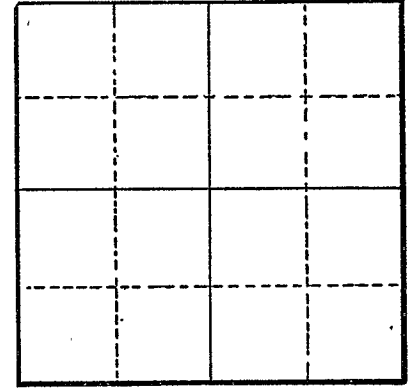

Section

Altitude at well

TYPE OF WELL: driven Date Constructed

Depth drilled 20 Depth cased 20

### CASING RECORD:

2-inch

### FINISH:

### AQUIFERS:

Gravel

### WATER LEVEL:

10-feet

PUMPING EQUIPMENT: Type Fairbanks Morse Centrifugal H.P. 5  
Capacity 120 G.P.M.

### WELL TESTS:

Drawdown ft. after hours Pumping 120 G.P.M.  
Drawdown ft. after hours G.P.M.

USE OF WATER irrigation Temp. °F., 19

SOURCE OF INFORMATION GR-2668

### DRILLER or DIGGER

ADDITIONAL DATA:  
Log Water Level Measurements Chemical Analysis Aquifer Test

### REMARKS:

Gravel all the way 20 20  
Water level varies with the rise and fall of the McKenzie River. It is approximately 10' below the surface in the summer months.