

STATE ENGINEER  
Salem, Oregon

# Well Record

STATE WELL NO. 17/3W-10M  
COUNTY Lane  
APPLICATION NO. GR-877


11090

OWNER: Vernon S. Johnson MAILING ADDRESS: \_\_\_\_\_

LOCATION OF WELL: Owner's No. 2 CITY AND STATE: Eugene, Oregon

NW  $\frac{1}{4}$  SW  $\frac{1}{4}$  Sec. 10 T. 17 S., R. 3 W., W.M.

Bearing and distance from section or subdivision corner 608.01 ft. S. of W $\frac{1}{4}$  cor. then E. 294 ft.

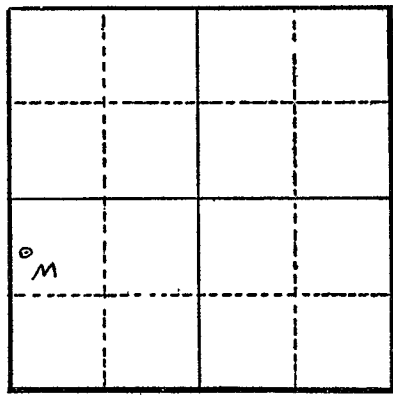

Section 10

Altitude at well 415 ft.

TYPE OF WELL: drilled Date Constructed April 1946

Depth drilled 20 ft. Depth cased 20 ft.

CASING RECORD: 2 in. & 3 in. pipe from 0 - 20 ft.

FINISH: \_\_\_\_\_

AQUIFERS: \_\_\_\_\_

WATER LEVEL: 11 ft.

PUMPING EQUIPMENT: Type Demming 2 inch H.P. 10  
Capacity 240 G.P.M. Belgian

WELL TESTS:  
Drawdown 2 ft. after \_\_\_\_\_ hours 180 G.P.M.  
Drawdown 9 ft. after \_\_\_\_\_ hours 220 G.P.M.

USE OF WATER irrigation Temp. \_\_\_\_\_ °F., 19

SOURCE OF INFORMATION owner

DRILLER or DIGGER \_\_\_\_\_

ADDITIONAL DATA:  
Log  Water Level Measurements \_\_\_\_\_ Chemical Analysis \_\_\_\_\_ Aquifer Test \_\_\_\_\_

REMARKS: Log: Soil 0 - 3 ft.  
Sand & gravel 3 - 20 ft.