

STATE ENGINEER
Salem, Oregon

Well Record

STATE WELL NO. 17/3W-10N
COUNTY Lane
APPLICATION NO. GR-878

OWNER: Alfred H. Johnson MAILING ADDRESS: LANE 1109g

LOCATION OF WELL: Owner's No. _____ CITY AND STATE: Eugene, Oregon

SW 1/4 SW 1/4 Sec. 10 T. 17 S., R. 3 W., W.M.


Bearing and distance from section or subdivision corner 26.94 ch. S. of 1/4 cor. thence E. 190'

Altitude at well 410 ft.

TYPE OF WELL: drilled Date Constructed May 1930

Depth drilled 20 Depth cased 20

CASING RECORD: 3 in. - 0 to 20 ft.

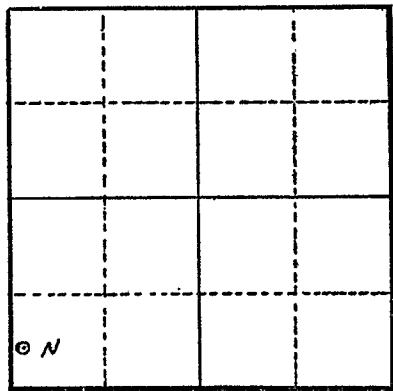

Section 10

FINISH: _____

AQUIFERS: _____

WATER LEVEL: 12 ft.

PUMPING EQUIPMENT: Type Demming 2 1/2 in. H.P. 40 elec. G.E.
Capacity _____ G.P.M.

WELL TESTS:
Drawdown 8 ft. after _____ hours 170 G.P.M.
Drawdown 5 ft. after _____ hours 160 G.P.M.

USE OF WATER irrigation Temp. _____ °F., 19 _____

SOURCE OF INFORMATION owner

DRILLER or DIGGER _____

ADDITIONAL DATA:
Log X Water Level Measurements _____ Chemical Analysis _____ Aquifer Test _____

REMARKS: Log: Soil 0 - 5 ft.
Sand & gravel 4 - 16 ft.