


STATE ENGINEER
Salem, Oregon

Well Record *2 ANTE* STATE WELL NO. 17/3W-10N
COUNTY Lane
APPLICATION NO. GR-3675

11093

OWNER: Fred G. Knox MAILING ADDRESS: Route 2, Box 282
CITY AND STATE: Eugene, Oregon

LOCATION OF WELL: Owner's No. _____
Well # 1
SW $\frac{1}{4}$ SW $\frac{1}{4}$ Sec. 10 T. 17 S, R. 3 W., W.M.
Bearing and distance from section or subdivision corner 460' N. & 75' E. of SW cor. Sec. 10

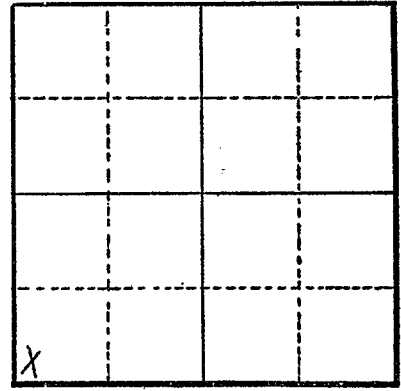

Section 10

Altitude at well _____

TYPE OF WELL: Driven Date Constructed 1947
Depth drilled 20 feet Depth cased _____

CASING RECORD:

FINISH:

Drilled well points from 17 to 20 feet

AQUIFERS:

WATER LEVEL:

16 feet below surface

PUMPING EQUIPMENT: Type A.C. - 1 1/2 Centrifugal H.P. 5
Capacity 30 G.P.M.

WELL TESTS:

Drawdown 2 ft. after _____ hours 50 G.P.M.
Drawdown _____ ft. after _____ hours _____ G.P.M.

USE OF WATER Irrigation Temp. _____ °F., 19

SOURCE OF INFORMATION Well Registration Statement

DRILLER or DIGGER _____

ADDITIONAL DATA:

Log Water Level Measurements _____ Chemical Analysis _____ Aquifer Test _____

REMARKS:

Log:	Thickness	Depth to Bottom
Soil and loam	8	8
Sand and gravel	12	20