

OWNER: Alfred H. Johnson

MAILING ADDRESS:

LANE 11095


LOCATION OF WELL: Owner's No. \_\_\_\_\_

CITY AND STATE:

Eugene, Oregon

SW  $\frac{1}{4}$  SW  $\frac{1}{4}$  Sec. 10 T. 17 N S., R. 3 E W., W.M.

Bearing and distance from section or subdivision corner 17.8 ch. E. of  $\frac{1}{4}$  cor. thence S. 26.94 ch. thence E. 6 ft.

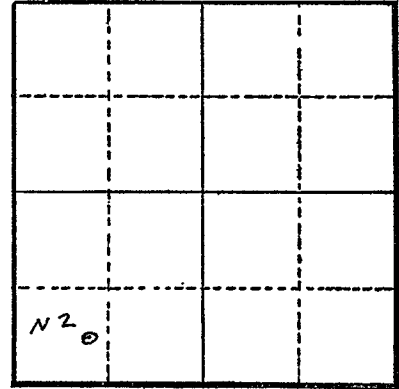

Section 10

Altitude at well 411 ft.

TYPE OF WELL: drilled Date Constructed June 1951

Depth drilled 20 Depth cased \_\_\_\_\_

CASING RECORD:

FINISH:

AQUIFERS:

WATER LEVEL: 13 ft.

PUMPING EQUIPMENT: Type Pacific 2 $\frac{1}{2}$  in. H.P. 10 elec. G.E.  
Capacity 250 G.P.M.

WELL TESTS:

Drawdown 7 ft. after \_\_\_\_\_ hours 220 G.P.M.  
Drawdown 3 ft. after \_\_\_\_\_ hours 180 G.P.M.

USE OF WATER irrigation Temp. \_\_\_\_\_ °F., 19

SOURCE OF INFORMATION owner

DRILLER or DIGGER \_\_\_\_\_

ADDITIONAL DATA:

Log  Water Level Measurements \_\_\_\_\_ Chemical Analysis \_\_\_\_\_ Aquifer Test \_\_\_\_\_

REMARKS: Log: Soil 0 - 2 $\frac{1}{2}$  ft.  
Sand & gravel 2 $\frac{1}{2}$  - 20 ft.