

STATE ENGINEER
Salem, Oregon

Well Record

STATE WELL-NO. 17/3W-10P
COUNTY Lane
APPLICATION NO. GR-2700


LANE
11097

OWNER: Fred G. Knox
MAILING ADDRESS: Route 2, Box 282

LOCATION OF WELL: Owner's No. #3
CITY AND STATE: Eugene, Oregon

SE 1/4 SW 1/4 Sec. 10 T. 17 S, R. 3 W., W.M.

Bearing and distance from section or subdivision corner 30' N. and 1860' E.

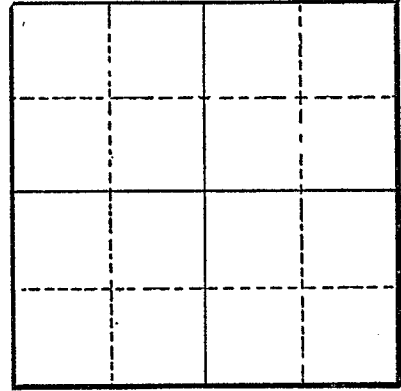

Section

Altitude at well

TYPE OF WELL: Driven Date Constructed 1950

Depth drilled 20 feet Depth cased

CASING RECORD:

FINISH:

Drilled well point from 16 ft. to 20 ft.

AQUIFERS:

soil, loam, sand and gravel

WATER LEVEL:

16'

PUMPING EQUIPMENT: Type Fairbanks Morse (Centrifugal) H.P.

Capacity 200 G.P.M.

WELL TESTS:

Drawdown 3 ft. after pumping 250 G.P.M.

Drawdown ft. after hours G.P.M.

USE OF WATER irrigation Temp. °F., 19

SOURCE OF INFORMATION GR-2558

DRILLER or DIGGER

ADDITIONAL DATA:

Log X Water Level Measurements Chemical Analysis Aquifer Test

REMARKS:

8' soil and loam 8 to 8
12' sand and gravel 8 to 20