

STATE ENGINEER
Salem, Oregon

Well Record ^{11/11/4} STATE WELL NO. 17/3W-14K
COUNTY Lane
APPLICATION NO. GR-3498

OWNER: James Seed Company


MAILING ADDRESS: 1235 Goodpasture Rd.

LOCATION OF WELL: Owner's No.

CITY AND STATE: Eugene, Oregon

NW 1/4 SE 1/4 Sec. 14 T. 17 S., R. 3 W., W.M.

Bearing and distance from section or subdivision
corner N. 18°30' W. 528 ft. from SW Cor. of DLC 78

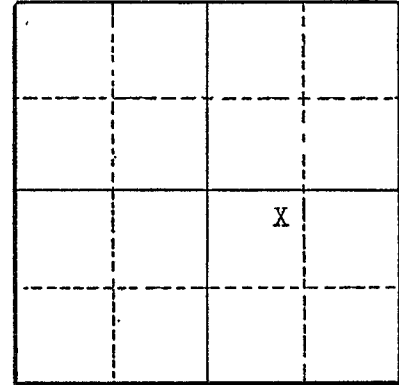

Section 14

Altitude at well

TYPE OF WELL: dug & drilled Date Constructed 1926

Depth drilled 25 ft. Depth cased 25 ft.

CASING RECORD:

36 inch casing set to 19 feet
4 inch casing from 19 to 25 feet

FINISH:

lower 4 ft. is perforated with 1/4" x 4" slots 2" apart from 21 to 25 ft.

AQUIFERS:

WATER LEVEL:

16 feet below surface

PUMPING EQUIPMENT: Type Fairbanks Morse centrifugal H.P. 10
Capacity 200 G.P.M.

WELL TESTS:

Drawdown 4 ft. after 200 hours G.P.M.
Drawdown ft. after hours G.P.M.

USE OF WATER Irrigation Temp. °F. 19
SOURCE OF INFORMATION Well Registration Statement Cert. # GR-3628

DRILLER or DIGGER

ADDITIONAL DATA:

Log X Water Level Measurements Chemical Analysis Aquifer Test

REMARKS:

Log: River loam Thickness 4 Depth to Bottom 4
water bearing sand and gravel 4 25