

STATE ENGINEER
Salem, Oregon

Well Record LANE

STATE WELL NO. 17/3W-14N
COUNTY LANE

11115 APPLICATION NO. GR-3083

OWNER: Benjamin W. Jordan

MAILING ADDRESS: Rt 2, Box 264 A

LOCATION OF WELL: Owner's No. _____

CITY AND STATE: Eugene, Oregon


SW 1/4 SW 1/4 Sec. 14 T. 17 S., R. 3 W., W.M.

Bearing and distance from section or subdivision corner _____

Altitude at well _____

TYPE OF WELL: Dug Date Constructed 1953

Depth drilled 8' Depth cased _____

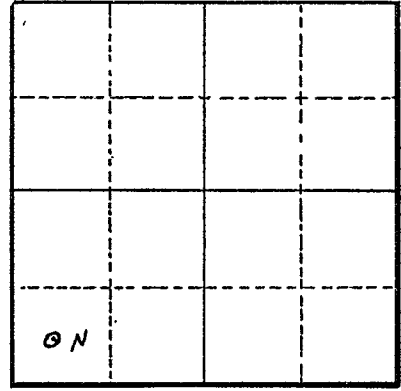

CASING RECORD:

FINISH:

AQUIFERS:

WATER LEVEL: 5'

PUMPING EQUIPMENT: Type Homart Sears Roebuck H.P. 5
Capacity 100 G.P.M.

WELL TESTS:
Drawdown _____ ft. after _____ hours _____ G.P.M.
Drawdown _____ ft. after _____ hours _____ G.P.M.

USE OF WATER Irrigation Temp. _____ °F. _____, 19____

SOURCE OF INFORMATION GR-3946

DRILLER or DIGGER _____

ADDITIONAL DATA:
Log NA Water Level Measurements _____ Chemical Analysis _____ Aquifer Test _____

REMARKS: