

STATE ENGINEER  
Salem, Oregon


Well Record **LANE** STATE WELL NO. 17/3W-15F  
11134 COUNTY Lane  
APPLICATION NO. GR-4007

OWNER: Harold E. Rice MAILING ADDRESS: Route 2, Box 272

LOCATION OF WELL: Owner's No. CITY AND STATE: Eugene, Oregon

SE 1/4 NW 1/4 Sec. 15 T. 17 S., R. 3 W., W.M.

Bearing and distance from section or subdivision  
corner 1950' E. & 450' N. from W. Cor. Sec. 15

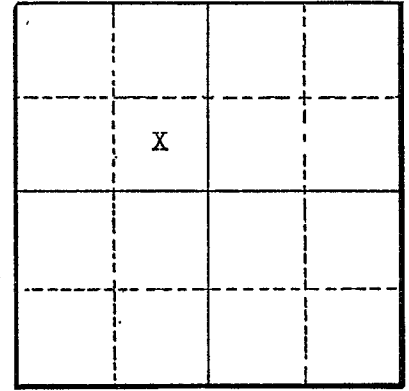

Section 15

Altitude at well

TYPE OF WELL: dug Date Constructed May, 1939

Depth drilled 18 ft. Depth cased

CASING RECORD:

FINISH:

AQUIFERS:

WATER LEVEL:

12 feet below surface

PUMPING EQUIPMENT: Type Fairbanks Morse H.P. 10  
Capacity 220 G.P.M.

WELL TESTS:

Drawdown 2 ft. after hours 250 G.P.M.  
Drawdown ft. after hours G.P.M.

USE OF WATER Irrigation Temp. °F., 19

SOURCE OF INFORMATION Well Registration Statement Cert. # GR-3614

DRILLER or DIGGER

ADDITIONAL DATA:

Log Water Level Measurements Chemical Analysis Aquifer Test

REMARKS: