

STATE ENGINEER
Salem, Oregon

Well Record

STATE WELL NO. 17/3W-15A
COUNTY Lane
APPLICATION NO. GR-31110

LANE
11135

OWNER: Herman J. Rotter


MAILING ADDRESS: Route 2, Box 326 A

LOCATION OF WELL: Owner's No. #2

CITY AND STATE: Eugene, Oregon

NE 1/4 NE 1/4 Sec. 15 T. 17 S., R. 3 W., W.M.

Bearing and distance from section or subdivision corner 700' S. and 413' W.

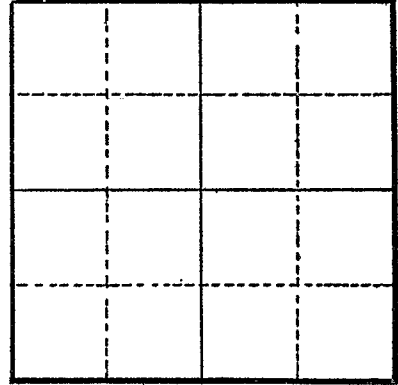

Section

Altitude at well

TYPE OF WELL: Drilled Date Constructed 1938

Depth drilled 21' Depth cased 21'

CASING RECORD:
3"

FINISH:
slatted

AQUIFERS:

WATER LEVEL:

16'

PUMPING EQUIPMENT: Type Pacific H.P. 7 1/2
Capacity 80 G.P.M.

WELL TESTS:

Drawdown ft. after hours G.P.M.
Drawdown ft. after hours G.P.M.

USE OF WATER Irrigation Temp. °F., 19

SOURCE OF INFORMATION GR-29114

DRILLER or DIGGER

ADDITIONAL DATA:

Log Water Level Measurements Chemical Analysis Aquifer Test

REMARKS: